

CARD MUST BE TYPED

State of Kansas
NOTICE OF INTENTION TO DRILL

CARD MUST BE SIGNED

(see rules on reverse side)

Starting Date: January 3, 1985
month day year

API Number 15-163-22,595-0000
205' East
of SW SE SW Sec 35 Twp 9 S, Rge 19 East West
(location)

OPERATOR: License # 5247/9639
Name Oil Property Management, Inc./Peregrine
Address 221 N. Main, Suite 220 Energy
City/State/Zip Wichita, KS 67202
Contact Person Alan C. Snider
Phone (316) 263-0134

330 Ft North from Southeast Corner of Section
3425 Ft West from Southeast Corner of Section
(Note: Locate well on Section Plat on reverse side)

CONTRACTOR: License # 5107
Name H-30 Drilling, Inc.
City/State Wichita, KS


Nearest lease or unit boundary line 330 feet.
County Rooks
Lease Name Thomas Well# 1-A

Well Drilled For: Well Class: Type Equipment:
 Oil Swd Infield Mud Rotary
 Gas Inj Pool Ext. Air Rotary
 OWWO Expl Wildcat Cable

Domestic well within 330 feet: yes no
Municipal well within one mile: yes no

If OWWO: old well info as follows:

Operator
Well Name
Comp Date Old Total Depth
Projected Total Depth 3700 feet
Projected Formation at TD Arbuckle
Expected Producing Formations Topeka, Lansing, Arbuckle

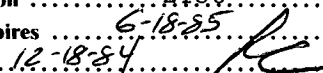Depth to Bottom of fresh water 250 feet
Lowest usable water formation Dakota
Depth to Bottom of usable water 950 feet
Surface pipe by Alternate: 1 2
Surface pipe to be set 270 feet
Conductor pipe if any required
Ground surface elevation 2180 feet MSL
This Authorization Expires 6-18-85
Approved By 12-18-84 

I certify that we will comply with K.S.A. 55-101, et seq., plus eventually plugging hole to K.C.C. specifications.

Date 12-18-84 Signature of Operator or Agent Alan C. Snider Title Vice President

MHC/KUOHE 12/18/84 Form C-1 4/84

CONSERVATION DIVISION
Wichita, Kansas

Must be filed with the K.C.C. five (5) days prior to commencing well
This card void if drilling not started within six (6) months of date received by K.C.C.


DEC 18 1984

12-18-84

STATE CORPORATION COMMISSION
RECEIVED
A Regular Section of Land
1 Mile = 5,280 Ft.

Important procedures to follow :

1. Notify District office before setting surface casing.
2. Set surface casing by circulating cement to the top.
3. File completion forms ACO-1 with K.C.C. within 90 days of well completion, following instructions on ACO-1, side 1, and including copies of wireline logs.
4. Notify District office 48 hours prior to old well workover or re-entry.
5. Prior to plugging, prepare a plugging plan, then obtain agreement from the appropriate district office for an approved plugging plan.
6. Submit plugging report (CP-4) to K.C.C. after plugging is completed.
7. Obtain an approved injection docket number before disposing of salt water.
8. Notify K.C.C. within 10 days when injection commences or terminates.
9. If an alternate 2 completion, cement in the production pipe from below any usable water to surface within 120 days of spud date.

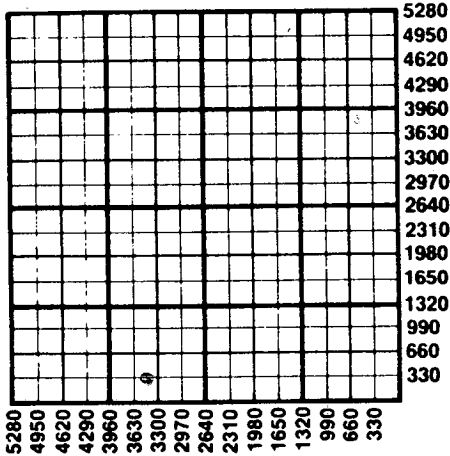

State Corporation Commission of Kansas
Conservation Division
200 Colorado Derby Building
Wichita, Kansas 67202
(316) 263-3238