

CARD MUST BE TYPED

State of Kansas  
NOTICE OF INTENTION TO DRILL

CARD MUST BE SIGNED

(see rules on reverse side)

Starting Date: Sept. 17, 1984  
month day year

API Number 15- 037-21,273-00-00

OPERATOR: License # 56.02

NW/4 Sec. 2 Twp 28 S, Rge 23 East  
(location)

Name N. & B. Enterprises

Address P.O. Box 884

City/State/Zip Chanute, Ks. 66720

Contact Person Edd Noland

Phone 316.431-9210

28.05 Ft North from Southeast Corner of Section

43.05 Ft West from Southeast Corner of Section

(Note: Locate well on Section Plat on reverse side)

CONTRACTOR: License # 5677

Name J. R. Burris Drilling

City/State P.O. Box 345 Iola, Ks. 66749

Nearest lease or unit boundary line 165 feet

County Crawford

Lease Name Burge Well# 18

Domestic well within 330 feet:  yes  no

Municipal well within one mile:  yes  no

Well Drilled For: Well Class: Type Equipment:

- Oil  Swd  Infield  Mud Rotary
- Gas  Inj  Pool Ext.  Air Rotary
- OWWO  Expl  Wildcat  Cable

Depth to Bottom of fresh water 110 feet

Lowest usable water formation

Depth to Bottom of usable water 100 feet

Surface pipe by Alternate: 1  2

Surface pipe to be set 20 feet

Conductor pipe if any required

Ground surface elevation feet MSL

This Authorization Expires 3-10-85

Approved By 9-10-84 [Signature]

If OWWO: old well info as follows:

Operator

Well Name

Comp Date Old Total Depth

Projected Total Depth 200 feet

Projected Formation at TD

Expected Producing Formations

I certify that we will comply with K.S.A. 55-101, et seq., plus eventually plugging hole to K.C.C. specifications.

Date 9/7/1984 Signature of Operator or Agent

[Signature: Edd Noland]

Title Partner


MHC/KUDHE 9/10/84

Must be filed with the K.C.C. five (5) days prior to commencing well  
This card void if drilling not started within six (6) months of date received by K.C.C.

**Important procedures to follow :**

**A Regular Section of Land**

1 Mile = 5,280 Ft.

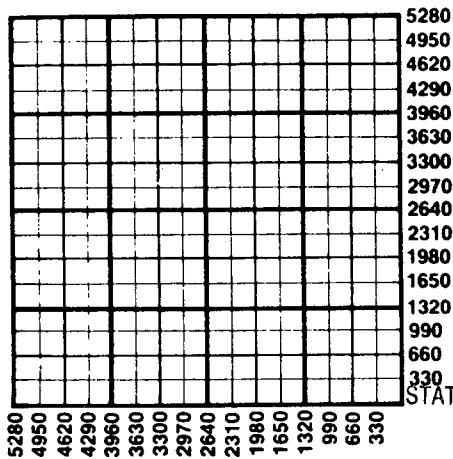

1. Notify District office before setting surface casing.
2. Set surface casing by circulating cement to the top.
3. File completion forms ACO-1 with K.C.C. within 90 days of well completion, following instructions on ACO-1, side 1, and including copies of wireline logs.
4. Notify District office 48 hours prior to old well workover or re-entry.
5. Prior to plugging, prepare a plugging plan, then obtain agreement from the appropriate district office for an approved plugging plan.
6. Submit plugging report (CP-4) to K.C.C. after plugging is completed.
7. Obtain an approved injection docket number before disposing of salt water.
8. Notify K.C.C. within 10 days when injection commences or terminates.

2. If an alternate 2 completion, cement in the production pipe from below any usable water to surface within 120 days of spud date.

RECEIVED

SFB 1 9 1984  
9-10-84  
CONSERVATION DIVISION  
Wichita, Kansas

State Corporation Commission of Kansas  
Conservation Division  
200 Colorado Derby Building  
Wichita, Kansas 67202  
(316) 263-3238