


STATE OF KANSAS
STATE CORPORATION COMMISSION

OR
FORMATION PLUGGING RECORD

Strike out upper line
when reporting plug-
ging of formations.

Give All Information Completely
Make Required Affidavit
Mail or Deliver Report to:
Conservation Division
State Corporation Commission
800 Bitting Building
Wichita, Kansas

Graham County Sec. 21 Twp. 10 Rge. ~~20~~ 21 (W)
Location as "NE $\frac{1}{4}$ NW $\frac{1}{4}$ SW $\frac{1}{4}$ " or footage from lines. NE NE NW
Lease Owner M. B. Armer
Lease Name Noah Well No. 1
Office Address 306 Insurance Bldg., Wichita 2, Kansas
Character of Well (completed as Oil, Gas or Dry Hole) dry hole
Date well completed May 17 19 49
Application for plugging filed " 17 19 49
Application for plugging approved " 17 19 49
Plugging commenced " 17 19 49
Plugging completed " 17 19 49
Reason for abandonment of well or producing formation Dry hole

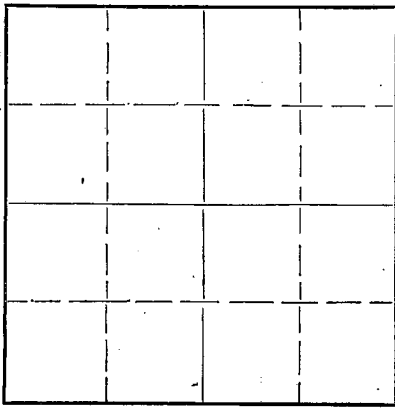

Locate well correctly on above
Section Plat

If a producing well is abandoned, date of last production 19
Was permission obtained from the Conservation Division or its agents before plugging was com-
menced? yes

Name of Conservation Agent who supervised plugging of this well M. A. Rives
Producing formation Depth to top Bottom Total Depth of Well 3842 Feet
Show depth and thickness of all water, oil and gas formations.

OIL, GAS OR WATER RECORDS

CASING RECORD

Formation	Content	From	To	Size	Put In	Pulled Out
Kansas City	dry	3455	3675			
Arbuckle	dry	3792	3842	8-5/8"	124' 8-5/8"	none

Describe in detail the manner in which the well was plugged, indicating where the mud fluid was placed and the method or methods used in introducing it into the hole. If cement or other plugs were used, state the character of same and depth placed, from feet to feet for each plug set.

Filled hole with heavy mud, set bottom plug @ 121'
cemented with 10 sacks cement, filled hole with mud
to top, plug set at 25' with 15 sacks cement.

RECEIVED
Conservation Div.
MAY 19 1949
STATE OF KANSAS
COMMISSION
KANSAS

(If additional description is necessary, use BACK of this sheet)

Correspondence regarding this well should be addressed to M. B. Armer
Address 306 Insurance Bldg., Wichita, Kansas


STATE OF Kansas COUNTY OF Sedgwick, ss.
Lloyd C. Sponenberg (employee of owner) or (owner or operator) of the above-described well,
being first duly sworn on oath, says: That I have knowledge of the facts, statements, and matters herein contained and the log of the above-
described well as filed and that the same are true and correct. So help me God.

(Signature) Lloyd C. Sponenberg
306 Insurance Bldg., Wichita, Kansas
(Address)

SUBSCRIBED AND SWORN to before me this 18th day of May, 19 49

My commission expires Sept. 17, 1951

Dorzel Walton
Notary Public.

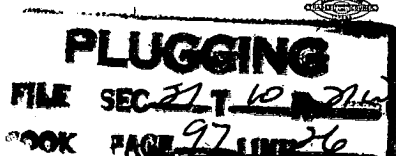

15-065-00103-00-00

Owner: M. B. Armer & Atlantic
Contractor: Armer Drilling Company, Inc.
Drilling Commenced: 5/2/49
Drilling Completed: 5/17/49
Elevation: 2196'
(rotary rig #1)

Farm: Noah #1
Location: NE NE NW 1/4 21-10-21
Graham County, Kansas
Casing record:
8-5/8" @ 121' cemented
with 75 sacks cement

(figures below indicate bottom)

Shale	385	
Shale & shells	700	
Sand & shale	1230	
Sand	1350	
Shale	1400	
Sand	1450	
Shale & shells	1630	
Red rock	1660	
Anhydrite	1680	
Lime-anhydrite	1710	
Shale & shells	1925	
Shale & lime	2058	
Shale	2180	
Lime	2435	
Lime & shale	2525	
Lime	2573	
Lime & shale	3235	
Lime	3675	
Shale & shells	3744	
Conglomerate	3792	
Dolomite	- total depth	3842 D & A

Heebner Shale (RB meas.)	3417
Lansing-KC	3455
Arbuckle	3792

I hereby certify that this is a true and correct log of the above described well as shown by the drilling reports.

ARMER DRILLING COMPANY, INC.

By *L. L. Spruick*

STATE OF KANSAS)
) SS
COUNTY OF SEDGWICK)

Subscribed and sworn to before me, a notary public, in and for said County and State this 18th day of May, 1949.

Walter Walton
Notary Public

My commission expires Sept. 17, 1951

05-19-1949

