


WELL PLUGGING RECORD

Give All Information Completely  
Make Required Affidavit  
Mail or Deliver Report to:  
Conservation Division  
State Corporation Commission  
212 No. Market  
Wichita, Kansas

NORTH

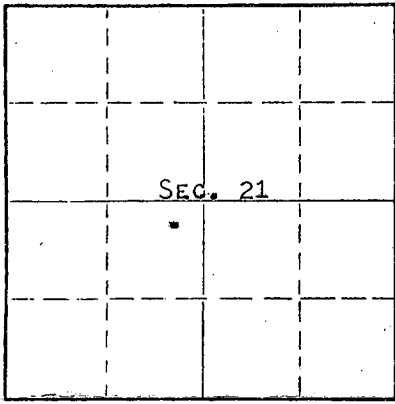

Locate well correctly on above  
Section Plat

GRAHAM County. Sec. 21 Twp. 10s Rge. 21 ~~XX~~ (W)  
Location as "NE/CNW/SW" or footage from lines APP. NE NE NW  
Lease Owner PETROLEUM, INC.,  
Lease Name ACHESON (WASH DOWN) Well No. 1  
Office Address R.R. #2, GREAT BEND, KANSAS  
Character of Well (completed as Oil, Gas or Dry Hole) DRY HOLE (WASHDOWN)  
Date well completed OCTOBER 31 1968  
Application for plugging filed OCTOBER 31 1968  
Application for plugging approved OCTOBER 31 1968  
Plugging commenced OCTOBER 31 1968  
Plugging completed OCTOBER 31 1968  
Reason for abandonment of well or producing formation NO PRODUCIBLE ZONE

If a producing well is abandoned, date of last production NONE 19  
Was permission obtained from the Conservation Division or its agents before plugging was commenced? YES

Name of Conservation Agent who supervised plugging of this well W. L. NICHOLS  
Producing formation \_\_\_\_\_ Depth to top \_\_\_\_\_ Bottom \_\_\_\_\_ Total Depth of Well 3850 Feet  
Show depth and thickness of all water, oil and gas formations.

OIL, GAS OR WATER RECORDS

CASING RECORD

FORMATION	CONTENT	FROM	TO	SIZE	PUT IN	PULLED OUT
				8-5/8"	121'	NONE
<p>RECEIVED STATE CORPORATION COMMISSION DEC 2 1968 CONSERVATION DIVISION Wichita, Kansas</p>						

Describe in detail the manner in which the well was plugged, indicating where the mud fluid was placed and the method or methods used in introducing it into the hole. If cement or other plugs were used, state the character of same and depth placed, from \_\_\_\_\_ feet to \_\_\_\_\_ feet for each plug set.

HEAVY MUD TO 1100', FOLLOWED WITH 70 SACKS CEMENT. HEAVY MUD TO 150', FOLLOWED WITH 20 SACKS CEMENT. HEAVY MUD TO 40', ROCK BRIDGE, 1/2 SACK HULLS, 10 SACKS CEMENT TO BASE OF WELL CELLAR.

(If additional description is necessary, use BACK of this sheet)

Name of Plugging Contractor GARVEY DRILLING CO.  
Address R.R. #2, GREAT BEND, KANSAS

STATE OF KANSAS, COUNTY OF BARTON, ss.

MONTE CHADD (employee of owner) or (owner or operator) of the above-described well, being first duly sworn on oath, says: That I have knowledge of the facts, statements, and matters herein contained and the log of the above-described well as filed and that the same are true and correct. So help me God. MONTE CHADD, DIST. PROD. SUPT.

(Signature)

R.R. #2, GREAT BEND, KANSAS  
(Address)

SUBSCRIBED AND SWORN TO before me this 27 day of NOVEMBER, 1968

My commission expires MAY 28, 1969

Richard H. Rumber  
Notary Public.