

15-065-00228-00-00


WELL PLUGGING RECORD

STATE OF KANSAS
 STATE CORPORATION COMMISSION
 Give All Information Completely
 Make Required Affidavit
 Mail or Deliver Report to:
 Conservation Division
 State Corporation Commission
 800 Bitting Building
 Wichita, Kansas

Graham County, Sec. 21 Twp. 10 Rge. (E) 21 (W)

Location as "NE/CNW $\frac{1}{4}$ SW $\frac{1}{4}$ " or footage from lines NW NW SE $\frac{1}{4}$
 Lease Owner M. B. Armer, et al
 Lease Name Noah "B" Well No. 1
 Office Address 710 Petroleum Building Wichita, Kansas
 Character of Well (completed as Oil, Gas or Dry Hole) Dry hole
 Date well completed Dec. 9 19 51
 Application for plugging filed Dec. 9 19 51
 Application for plugging approved Dec. 9 19 51
 Plugging commenced Dec. 9 19 51
 Plugging completed Dec. 9 19 51
 Reason for abandonment of well or producing formation Dry

NORTH

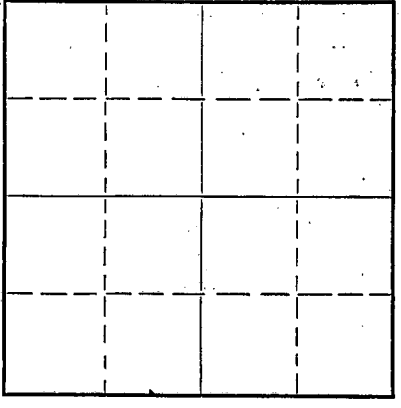

Locate well correctly on above Section Plat

If a producing well is abandoned, date of last production 19
 Was permission obtained from the Conservation Division or its agents before plugging was commenced? Yes

Name of Conservation Agent who supervised plugging of this well Eldon Petty
 Producing formation _____ Depth to top _____ Bottom _____ Total Depth of Well 3855 Feet
 Show depth and thickness of all water, oil and gas formations.

OIL, GAS OR WATER RECORDS

CASING RECORD

Formation	Content	From	To	Size	Put In	Pulled Out
				8-5/8	246	none

Describe in detail the manner in which the well was plugged, indicating where the mud fluid was placed and the method or methods used in introducing it into the hole. If cement or other plugs were used, state the character of same and depth placed, from _____ feet to _____ feet for each plug set.

Circulated hole with heavy mud, pushed cementing plug to 210 ft. Displaced 15 sacks of cement through drill pipe. Filled with heavy mud to 40 ft., set cementing plug and 1/2 sack hulls and 10 sacks cement to bottom of cellar.

RECEIVED
 STATE CORPORATION COMMISSION
 DEC 18 1951
 CONS 12-18-1951
 WICHITA, KANSAS

(If additional description is necessary, use BACK of this sheet)

Name of Plugging Contractor Woody Speer
 Address 710 Petroleum Building, Wichita, Kansas

STATE OF Kansas COUNTY OF Bedgwick ss.

L. C. Sporenberg (employee of owner) or ~~owner~~ of the above-described well, being first duly sworn on oath, says: That I have knowledge of the facts, statements, and matters herein contained and the log of the above-described well as filed and that the same are true and correct. So help me God.

(Signature) L. C. Sporenberg
 (Address) _____

SUBSCRIBED AND SWORN to before me this 17th day of December, 19 51

Hazel Walton Notary Public.

My commission expires Sept 17, 1955

PLUGGING
 FILE DEC 21 10 21 AM '51
 BOOK 131 page 2

15-065-00228-00-00

DRILLING LOG

Company- M. B. Armer
Contractor- Woody Speer
Drilling commenced- 11-27-51
Drilling completed- 12-9-51
Elevation- 2175 D.F. 2178 K.B.

Farm- Noah "B" #1
Location- W $\frac{1}{2}$ SE $\frac{1}{4}$
21-10-21W
Graham Co., Kans.
Casing Record- 8-5/8"
O D @ 246'
w/200 sacks cement

(FIGURES BELOW INDICATE BOTTOM)

Shale and shells	830
Sand and shale	1110
Sand and shells	1410
Red bed and shale	1660
Anhydrite	1670
Shale and shells	2155
Lime and shale	2185
Shale and shells	2475
Shale and lime	2610
Shale and shells	2675
Shale and lime	2805
Shale and shells	2905
Lime and shale	2995
Shale and lime	3180
Lime, shale and iron	3230
Shale and lime	3385
Lime and shale	3425
Lime	3485
Lime and shale	3535
Lime	3710
Lime and shale	3755
Lime	3780
Lime, shale and chert	3815
Lime and shale	3838
Lime, shale and chert	3855
B.T.D.	3855

FORMATION TOPS (R.B. Measurement)

Anhydrite	1660
Heebner	3425
Toronto	3444
Kansas City	3465
Conglomerate	3789
Arbuckle	3820

I hereby certify that this is a true and correct log of the above described well as shown by the drilling reports.

WOODY SPEER

12-18-1951

By

W. Speer

STATE OF KANSAS

} SS

COUNTY OF SEDGWICK

Subscribed and sworn to before me, a notary public, in and for said County and State this 14-th day of December, 1951.

My commission expires Sept. 17, 1955

My commission expires _____

Harold Dalton
Notary Public

21 10 21W
131