


15-065-02421-00-00

WELL PLUGGING RECORD

Give All Information Completely  
Make Required Affidavit  
Mail or Deliver Report to:  
Conservation Division  
State Corporation Commission  
800 Bittling Building  
Wichita, Kansas

NORTH

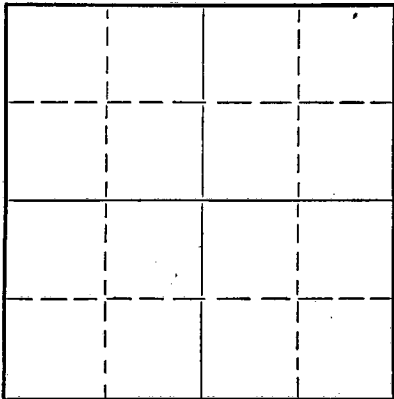

Locate well correctly on above Section Plat

Graham County, Sec. 27 Twp 10S Rge. (E) 21 (W)  
Location as "NE/CNW 1/4 SW 1/4" or footage from lines 330 from E and 330 from N, SE/4  
Lease Owner Phillips Petroleum Company  
Lease Name Rutile Well No. 1  
Office Address Box 779, Great Bend, Kansas  
Character of Well (completed as Oil, Gas or Dry Hole) Dry Hole  
Date well completed March 20, 1955  
Application for plugging filed March 21, 1955  
Application for plugging approved March 23, 1955  
Plugging commenced March 21, 1955  
Plugging completed March 21, 1955  
Reason for abandonment of well or producing formation Dry Hole

If a producing well is abandoned, date of last production - 19 -  
Was permission obtained from the Conservation Division or its agents before plugging was commenced? Yes.

Name of Conservation Agent who supervised plugging of this well Eldon Petty  
Producing formation Arbuckle Depth to top 3756 Bottom 3785 Total Depth of Well 3785 Feet  
Show depth and thickness of all water, oil and gas formations.

OIL, GAS OR WATER RECORDS

CASING RECORD

Formation	Content	From	To	Size	Put In	Pulled Out
Anhydrite	Dry	1608	-	9-5/8"	243.40'	None
Howard	Dry	3172	3196			
Topeka	Dry	3196	3382			
Heebner	Dry	3382	3404			
Toronto	Dry	3404	3423			
Lansing-Kansas City	Dry	3423	3658			
Arbuckle	Dry	3756	3785			

Describe in detail the manner in which the well was plugged, indicating where the mud fluid was placed and the method or methods used in introducing it into the hole. If cement or other plugs were used, state the character of same and depth placed, from feet to feet for each plug set.

Mudded hole from 3785' to 240'. Pushed plug to 240'. Spotted 20 sx. cement. Dumped mud and pushed plug to 35'. Dumped 1/2 sack cotton seed hulls. Dumped 15 sx. cement in filling to base of cellar. Well plugged and abandoned at 5:00 P.M. 3-21-55.

RECEIVED  
STATE CORPORATION COMMISSION  
MAR 26 1955  
03-26-1955  
CONSERVATION DIVISION  
WICHITA, KANSAS

(If additional description is necessary, use BACK of this sheet)

Name of Plugging Contractor Stag Drilling Company  
Address Chase, Kansas

STATE OF Kansas, COUNTY OF Barton, ss.  
A. J. Willis (employee of owner) of the above-described well,  
being first duly sworn on oath, says: That I have knowledge of the facts, statements, and matters herein contained and the log of the above-described well as filed and that the same are true and correct. So help me God.

(Signature) *A. J. Willis*  
Box 779, Great Bend, Kansas  
(Address)

SUBSCRIBED AND SWORN to before me this 25th day of March, 1955  
My commission expires November 18, 1957

*Josephine Beal*  
Notary Public.



PLUGGING  
FILE SEC 27 T 10 R 21W  
BOOK PAGE 106 LINE 26

15-065-02421-0002 EXPLORATION RECORD

- 1 - Bull. Prod.
- 1 - Division
- 1 - District
- 1 - Geological Dept. - Bull.
- 1 - Geological Dept. - District

Phillips Petroleum Company  
 330' from East and 330' from North lines,  
 SE/4 Sec. 27-10S-21W, Graham County, Kansas

Lease Butte Well 1

Formation Name	Top	Base	Remarks
Sand and shale	0	251	
Shale	251	290	
Sandy shale	290	500	
White shale	500	710	
White sand	710	820	
Shale and shells	820	1100	
Sand and shale	1100	1350	
White shale, shells & redbed	1350	1635	
Lime and shale	1635	1690	
Shale and shells	1690	2150	
Lime, shale, and sand streaks	2150	2300	
Lime and shale	2300	2745	
Lime	2745	2830	
Lime and shale	2830	3052	
Lime	3052	3382	
Shale	3382	3386	
Lime	3386	3400	
Lime and shale	3400	3411	
Lime	3411	3520	**Drill Stem Test
Lime and shale	3520	3573	
Lime	3573	3653	
Lime and shale	3653	3724	
Conglomerate	3724	3760	
Sandy shale	3760	3785*	

\*Not penetrated at 3785' TD.  
 \*\*See Daily Report Detailed.

FORMATION TOPS:

Topeka	3195
Hestner	3382
Toronto	3405
Lansing-Kansas City	3423
Base Kansas City	3653
Arbuckle	3756
Rotary TD	3785

MIR 26 1955  
 CONS 03-26-1955  
 Wichita, Kansas

**PLUGGING**  
 FILE SEC 27-10-21W  
 BOOK PAGE 106 LINE 26