


STATE OF KANSAS  
STATE CORPORATION COMMISSION

Give All Information Completely  
Make Required Affidavit  
Mail or Deliver Report to:  
Conservation Division  
State Corporation Commission  
211 No. Broadway  
Wichita, Kansas

15-065-02392-00-00

WELL PLUGGING RECORD

NORTH

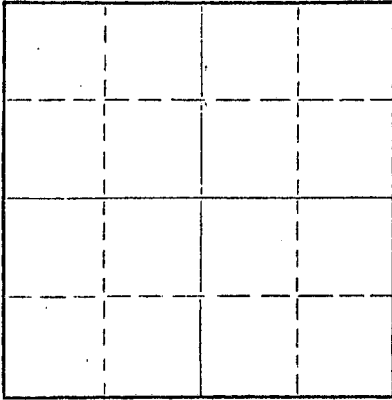

Locate well correctly on above  
Section Plat

Graham County, Sec. 28 Twp. 10S Rge. (E) 21 (W)

Location as "NE/CNW%SW%" or footage from lines SW NE NE  
Lease Owner Abercrombie Drilling, Inc.  
Lease Name HOLMES Well No. 1  
Office Address 801 Union Center, Wichita, Kansas  
Character of Well (completed as Oil, Gas or Dry Hole) Dry  
Date well completed February 16, 19 64  
Application for plugging filed verbally - February 15, 19 64  
Application for plugging approved verbally - February 15, 19 64  
Plugging commenced February 16, 19 64  
Plugging completed February 16, 19 64  
Reason for abandonment of well or producing formation Dry

If a producing well is abandoned, date of last production \_\_\_\_\_ 19\_\_\_\_  
Was permission obtained from the Conservation Division or its agents before plugging was commenced? verbally - yes.

Name of Conservation Agent who supervised plugging of this well \_\_\_\_\_  
Producing formation \_\_\_\_\_ Depth to top \_\_\_\_\_ Bottom \_\_\_\_\_ Total Depth of Well 3840 Feet  
Show depth and thickness of all water, oil and gas formations.

OIL, GAS OR WATER RECORDS

CASING RECORD

FORMATION	CONTENT	FROM	TO	SIZE	PUT IN	PULLED OUT
				8-5/8"	199'	None

Describe in detail the manner in which the well was plugged, indicating where the mud fluid was placed and the method or methods used in introducing it into the hole. If cement or other plugs were used, state the character of same and depth placed, from \_\_\_\_\_ feet to \_\_\_\_\_ feet for each plug set.

Filled hole with heavy mud to 550'.  
Set 1st plug at 550' w/20 sx through drill pipe.  
Set 2nd plug at 185' w/20 sx & 1/4 sk hulls.  
Set 3rd plug at 40' w/10 sx cement & 1/2 sk hulls.  
Job completed 12:30 A. M. 2-16-64

RECEIVED  
STATE CORPORATION COMMISSION

FEB 21 1964  
02-21-1964  
CONSERVATION DIVISION  
Wichita, Kansas

(If additional description is necessary, use BACK of this sheet)  
Name of Plugging Contractor Abercrombie Drilling, Inc.  
Address 801 Union Center, Wichita, Kansas

STATE OF Kansas, COUNTY OF Sedgwick, ss.  
B. Lynn Herrington (employee of owner) or (~~owner or operator~~) of the above-described well, being first duly sworn on oath, says: That I have knowledge of the facts, statements, and matters herein contained and the log of the above-described well as filed and that the same are true and correct. So help me God.

(Signature) B. Lynn Herrington  
801 Union Center, Wichita, Kansas.  
(Address)

SUBSCRIBED AND SWORN to before me this 20th day of February, 19 64  
Leah Faye Hefke  
Leah Faye Hefke Notary Public.



15-015-02392-00-00

CONTRACTOR'S WELL LOG

COMPANY: Abercrombie Drilling, Inc.  
 CONTRACTOR: Abercrombie Drilling, Inc.  
 FARM: HOLMES #1  
 LOCATION: SW NE NE Sec. 28-10S-21W  
 Graham County, Kansas  
 COMMENCED: February 7, 1964  
 COMPLETED: February 16, 1964

0	120	Clay & Sand
120	410	Shale, & Sand Streaks
410	1105	Shale
1105	1670	Shale & Sand
1670	1690	Shale
1690	1748	Anhydrite
1748	1893	Shale & Shells
1893	2334	Shale
2334	3422	Shale & Lime
3422	3840	Lime
	3840	Rotary Total Depth

ELEVATION: 2218' D. F. & K. B.

SAMPLE TOPS:

Topeka	3273'	(-1055)
Heebner	3458'	(-1240)
Toronto	3482'	(-1264)
Lansing	3497'	(-1279)
Base Kansas City	3735'	(-1517)
Arbuckle	3836'	(-1618)

**RECEIVED**  
STATE CORPORATION COMMISSION

FEB 21 1964  
02-21-1964  
CONSERVATION DIVISION  
Wichita, Kansas

Set 8-5/8" surface casing at 199' with 150 sx HA5 Sunset Cement.

DRY & ABANDONED

STATE OF KANSAS            )  
                                   ) SS  
 COUNTY OF SEDGWICK        )

I, B. Lynn Herrington, do hereby certify that the above and foregoing is a true and correct copy of the log of the HOLMES #1, SW NE NE, Section 28-10S-21W, Graham County, Kansas, as reflected by the files of Abercrombie Drilling, Inc.

B. Lynn Herrington  
B. Lynn Herrington

Subscribed and sworn to before me, a Notary Public, in and for Sedgwick County, Kansas, this 20th day of February, 1964.

Leah Faye Hefke  
Leah Faye Hefke, Notary Public

My commission expires June 16, 1967.