


WELL PLUGGING RECORD

Give All Information Completely
Make Required Affidavit
Mail or Deliver Report to:
Conservation Division
State Corporation Commission
800 Bitting Building
Wichita, Kansas

NORTH

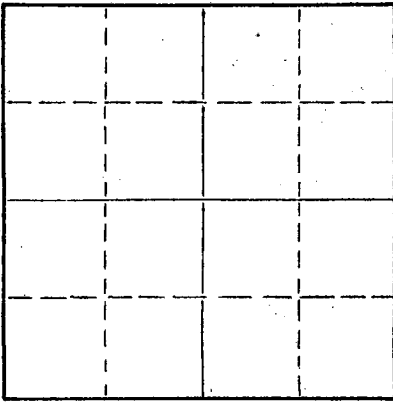

Locate well correctly on above Section Plat

Graham County. Sec. 28 Twp. 10 Rge. (E) 21 (W)
Location as "NE/CNW&SW" or footage from lines SE SE SE/4
Lease Owner Herman Geo. Kaiser, Oil Producer
Lease Name Svoboda Well No. 1
Office Address 908 Palace Bldg., Tulsa, Okla.
Character of Well (completed as Oil, Gas or Dry Hole) Dry Hole
Date well completed March 28, 19 55
Application for plugging filed " " 19 "
Application for plugging approved " " 19 "
Plugging commenced " " 19 "
Plugging completed " " 19 "
Reason for abandonment of well or producing formation dry

If a producing well is abandoned, date of last production 19
Was permission obtained from the Conservation Division or its agents before plugging was commenced? Yes

Name of Conservation Agent who supervised plugging of this well Eldon Petty
Producing formation Depth to top Bottom Total Depth of Well 3840 Feet
Show depth and thickness of all water, oil and gas formations.

OIL, GAS OR WATER RECORDS

CASING RECORD

FORMATION	CONTENT	FROM	TO	SIZE	PUT IN	PULLED OUT
				8 5/8"	191'	None

Describe in detail the manner in which the well was plugged, indicating where the mud fluid was placed and the method or methods used in introducing it into the hole. If cement or other plugs were used, state the character of same and depth placed, from feet to feet for each plug set.

Circulated hole with heavy Rotary Mud, set cementing plug
at 185 ft., dumped 1/2 sack hulls and 15 sacks cement.
Mudded hole to 40 ft., set cementing plug and 1/2 sack hulls
and 10 sacks cement, filling to bottom of cellar.

(If additional description is necessary, use BACK of this sheet)

Name of Plugging Contractor H-30, Inc.
Address 710 Petroleum Building, Wichita, Kansas

STATE OF KANSAS, COUNTY OF SEDGWICK, ss. Employee of Contractor
L. C. Sponenberg (employee of owner) or (sworn officer) of the above-described
well, being first duly sworn on oath, says: That I have knowledge of the facts, statements, and matters herein contained and the log of the
above-described well as filed and that the same are true and correct. So help me God.

(Signature) *L. C. Sponenberg*
(Address)

SUBSCRIBED AND SWORN TO before me this 1st day of April, 19 55

My commission expires February 13, 1956.

Rose Turey
Notary Public.

PLUGGING
FILE SEC 28 T 10 R 21W
BOOK PAGE 108 LINE 27

RECEIVED
STATE CORPORATION COMMISSION
04-05-1955
APR - 5 1955
CONSERVATION DIVISION
Wichita, Kansas

15-065-00756-00-00

KANSAS GEOLOGICAL SOCIETY
KANSAS WELL LOG BUREAU - KANSAS WELL SAMPLE BUREAU
KANSAS GEOLOGICAL SOCIETY BUILDING
508 EAST MURDOCK - WICHITA, KANSAS

COMPANY Herman Geo. Kaiser, Oil Producer

SEC. 28 T. 10S R. 21W
LOC. SE SE SE

FARM Svoboda

NO. 1

TOTAL DEPTH 3840'

COUNTY Graham

COMM. 3/15/55


COMP. 3/28/55

KANSAS

SHOT OR TREATED

CONTRACTOR H-30, Inc.

ISSUED

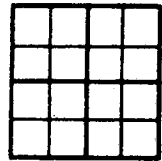

CASING

20	10
15	8 191'
12	6
13	5

ELEVATION 2214 K.B.

PRODUCTION D & A

FIGURES INDICATE BOTTOM OF FORMATIONS

Surface Clay & Sand	75
Shale	815
Sand	910
Shale	1180
Sand with Shale Streaks	1410
Shale & Red Bed	1730
Anhydrite	1765
Red Bed & Shale	2020
Shale & Shells & Salt	2230
Shale & Lime	3417
Lime	3457
Lime & Shale	3497
Lime	3541
Lime & Shale	3816
Lime	3840

FORMATION TOPS

HEEBNER	3450
TORONTO	3471
LANSING	3490
BASE KANSAS CITY	3726
MARMATON CHERT	3785
CONGLOMERATE	3812
ARBUCKLE	3816

I hereby certify that this is a true and correct log of the above described well as shown by the drilling reports.

H-30, INC.

By *R. P. Spawley*

STATE OF KANSAS)
) SS:
COUNTY OF SEDGWICK)

Subscribed and sworn to before me, a notary public, in and for said County and State this 31st day of March, 1955.

Rose Fussey
Notary Public

My Commission expires February 13, 1956.

PLUGGING
FILE SEC. 28 T. 10 S. R. 21 W
BOOK PAGE 108 LINE 27

RECEIVED
STATE CORPORATION COMMISSION
APR - 5 1955
04-05-1955
CONSERVATION DIVISION
Wichita, Kansas