

CARD MUST BE TYPED

State of Kansas
NOTICE OF INTENTION TO DRILL
(see rules on reverse side)

CARD MUST BE SIGNED

Starting Date: May 24, 85
month day year 4:00

OPERATOR: License # 5188
Name Silver Creek Oil & Gas, Inc.
Address 1900 N. Amidon Ste. 221
City/State/Zip Wichita, KS 67203
Contact Person Gregory B. Porterfield
Phone (316) 832-0603

CONTRACTOR: License #
Name same
City/State

Well Drilled For: Well Class: Type Equipment:
 Oil Swd Infield Mud Rotary
 Gas Inj Pool Ext. Air Rotary
 OWWO Expl Wildcat Cable

If OWWO: old well info as follows:

Operator
Well Name
Comp Date Old Total Depth
Projected Total Depth 3350 feet
Projected Formation at TD 3350
Expected Producing Formations Arbuckle

API Number 15- 173-20,711-00-00
 East
NE SE SW (location) Sec 2 Twp 27 S Rge 2 West

.990 Ft North from Southeast Corner of Section
.2970 Ft West from Southeast Corner of Section
(Note: Locate well on Section Plat on reverse side)

Nearest lease or unit boundary line 330 feet.
County Sedgwick
Lease Name Ketteman Well# 1
Domestic well within 330 feet: yes no
Municipal well within one mile: yes no

Depth to Bottom of fresh water 98 feet
Lowest usable water formation Wellingford
Depth to Bottom of usable water 200 feet
Surface pipe by Alternate: 1 2
Surface pipe to be set 200 feet
Conductor pipe if any required _____ feet
Ground surface elevation _____ feet MSL
This Authorization Expires 11-24-85
Approved By 5-24-85 *[Signature]*

I certify that we will comply with K.S.A. 55-101, et seq., plus eventually plugging hole to K.C.C. specifications.

Date May, 24, 85 Signature of Operator or Agent *[Signature]* Title Secretary

RECEIVED

STATE CORPORATION COMMISSION

Must be filed with the K.C.C. five (5) days prior to commencing well
This card void if drilling not started within six (6) months of date received by K.C.C.

MAY 24 1985


5-24-85

CONSERVATION DIVISION

Wichita, Kansas

A Regular Section of Land

1 Mile = 5,280 Ft.

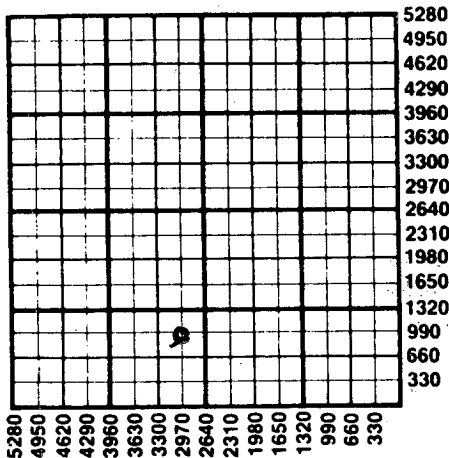

Important procedures to follow :

1. Notify District office before setting surface casing.
2. Set surface casing by circulating cement to the top.
3. File completion forms ACO-1 with K.C.C. within 90 days of well completion, following instructions on ACO-1, side 1, and including copies of wireline logs.
4. Notify District office 48 hours prior to old well workover or re-entry.
5. Prior to plugging, prepare a plugging plan, then obtain agreement from the appropriate district office for an approved plugging plan.
6. Submit plugging report (CP-4) to K.C.C. after plugging is completed.
7. Obtain an approved injection docket number before disposing of salt water.
8. Notify K.C.C. within 10 days when injection commences or terminates.
9. If an alternate 2 completion, cement in the production pipe from below any usable water to surface within 120 days of spud date.

**State Corporation Commission of Kansas
 Conservation Division
 200 Colorado Derby Building
 Wichita, Kansas 67202
 (316) 263-3238**