

CARD MUST BE TYPED

State of Kansas
NOTICE OF INTENTION TO DRILL
(see rules on reverse side)

CARD MUST BE SIGNED

Starting Date: 6-15-85
month day year

API Number 15- 173-20,712-00-00

OPERATOR: License # 5152 100' N

C. E/2 E/2 NW/4 Sec . 1 . Twp . 28 . S, Rge . 2E. East
 West
(location)

Name Lee Banks

Address 200 W. Douglas #550

City/State/Zip Wichita, KS 67202

Contact Person Lee Banks

Phone 316-267-0783

4060 Ft North from Southeast Corner of Section
2970 Ft West from Southeast Corner of Section
(Note: Locate well on Section Plat on reverse side)

CONTRACTOR: License # 5302

Name Red Tiger Drilling

City/State Wichita, KS

Nearest lease or unit boundary line 330 feet.
County Sedgwick

Lease Name Banks Well# 1

Domestic well within 330 feet: yes no

Municipal well within one mile: yes no

Well Drilled For: Well Class: Type Equipment:

- Oil Swd Infield Mud Rotary
- Gas Inj Pool Ext. Air Rotary
- OWWO Expl Wildcat Cable

Depth to Bottom of fresh water 125 feet

Lowest usable water formation Wellington

Depth to Bottom of usable water 200 feet

Surface pipe by Alternate: 1 2

Surface pipe to be set 200 feet

Conductor pipe if any required n/a feet

Ground surface elevation 1335 feet MSL

This Authorization Expires ~~7-85~~ 12-12-85

Approved By  6-12-85

If OWWO: old well info as follows:

Operator

Well Name

Comp Date Old Total Depth

Projected Total Depth 3200 feet

Projected Formation at TD Simpson

Expected Producing Formations Kansas City, Simpson

I certify that we will comply with K.S.A. 55-101, et seq., plus eventually plugging hole to K.C.C. specifications.

6-11-85

Date Signature of Operator or Agent 

Title owner

MHC/KDHE 6-12-85

RECEIVED
STATE CORPORATION COMMISSION


Must be filed with the K.C.C. five (5) days prior to commencing well
This card void if drilling not started within six (6) months of date received by K.C.C.

JUN 1 1 1985

6-11-85

CONSERVATION DIVISION

A Regular Section of
1 Mile = 5,280 Ft.

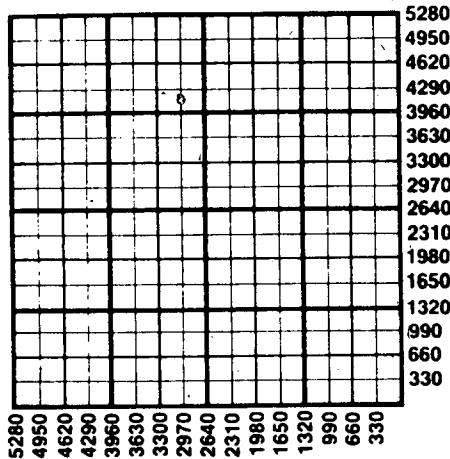

Important procedures to follow:

1. Notify District office before setting surface casing.
2. Set surface casing by circulating cement to the top.
3. File completion forms ACO-1 with K.C.C. within 90 days of well completion, following instructions on ACO-1, side 1, and including copies of wireline logs.
4. Notify District office 48 hours prior to old well workover or re-entry.
5. Prior to plugging, prepare a plugging plan, then obtain agreement from the appropriate district office for an approved plugging plan.
6. Submit plugging report (CP-4) to K.C.C. after plugging is completed.
7. Obtain an approved injection docket number before disposing of salt water.
8. Notify K.C.C. within 10 days when injection commences or terminates.
9. If an alternate 2 completion, cement in the production pipe from below any usable water to surface within 120 days of spud date.

State Corporation Commission of Kansas
Conservation Division
200 Colorado Derby Building
Wichita, Kansas 67202
(316) 263-3238