


STATE OF KANSAS  
STATE CORPORATION COMMISSION

WELL PLUGGING RECORD

Give All Information Completely  
Make Required Affidavit  
Mail or Deliver Report to:  
Conservation Division  
State Corporation Commission  
211 No. Broadway  
Wichita, Kansas

NORTH

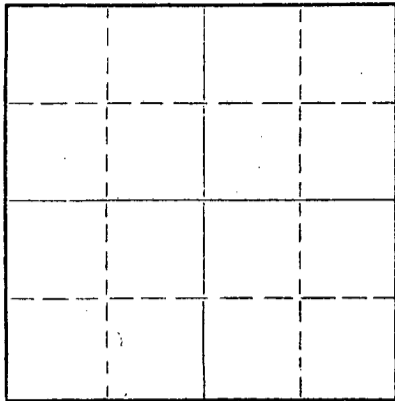

Locate well correctly on above  
Section Plat

Sedgwick County. Sec. 8 Twp. 27S Rge. 2 (E)<sup>X</sup> (W)  
Location as "NE/CNW%SW%" or footage from lines C NW/4 SE/4 NE/4  
Lease Owner Griggs Oil Inc.  
Lease Name Wilson Well No. 1 **AVB  
cc**  
Office Address Suite 1625, 125 N. Market Wichita, Ks  
Character of Well (completed as Oil, Gas or Dry Hole) Dry hole  
Date well completed 10/6 19 79  
Application for plugging filed 10/6 19 79  
Application for plugging approved 10/6 19 79  
Plugging commenced 10/6 19 79  
Plugging completed 10/6 19 79  
Reason for abandonment of well or producing formation \_\_\_\_\_

If a producing well is abandoned, date of last production \_\_\_\_\_ 19\_\_\_\_  
Was permission obtained from the Conservation Division or its agents before plugging was commenced? yes

Name of Conservation Agent who supervised plugging of this well Carl R. Barnett  
Producing formation \_\_\_\_\_ Depth to top \_\_\_\_\_ Bottom \_\_\_\_\_ Total Depth of Well 3396' Feet  
Show depth and thickness of all water, oil and gas formations.

OIL, GAS OR WATER RECORDS

CASING RECORD

FORMATION	CONTENT	FROM	TO	SIZE	PUT IN	PULLED OUT
				8 5/8	151'	-

Describe in detail the manner in which the well was plugged, indicating where the mud fluid was placed and the method or methods used in introducing it into the hole. If cement or other plugs were used, state the character of same and depth placed, from \_\_\_\_\_ feet to \_\_\_\_\_ feet for each plug set.

Set plug #1 @ 160' 25 sks. Cement  
plug #2 @ 40' 10 sks. cement  
5 sks. in rathole; jet pits

RECEIVED  
STATE CORPORATION COMMISSION  
MAR 20 1980  
9-20-80  
CONSERVATION DIVISION  
Wichita, Kansas


(If additional description is necessary, use BACK of this sheet)  
Name of Plugging Contractor Blue Streak Drilling  
Address 1408 Douglas Building, Wichita, Kansas 67202

STATE OF Kansas COUNTY OF Sedgwick, ss.  
Carole A. Neal (employee of owner) or (owner or operator) of the above-described well, being first duly sworn on oath, says: That I have knowledge of the facts, statements, and matters herein contained and the log of the above-described well as filed and that the same are true and correct. So help me God.

(Signature) Carole A. Neal  
1625 Vickers-KSB&T Bldg., Wichita, KS 67202  
(Address)

SUBSCRIBED AND SWORN TO before me this 19 day of March, 1980

My commission expires \_\_\_\_\_

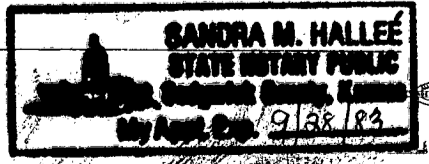

Sandra M. Hallee  
Sandra M. Hallee Notary Public.