


15-173-19050-00-00

STATE OF KANSAS
STATE CORPORATION COMMISSION

WELL PLUGGING RECORD

Give All Information Completely
Make Required Affidavit
Mail or Deliver Report to:
Conservation Division
State Corporation Commission
800 Bitting Building
Wichita, Kansas

NORTH

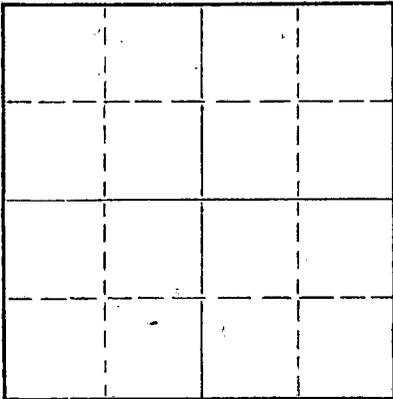

Locate well correctly on above
Section Plat

Sedgwick County. Sec. 10 Twp. 27 Rge. 2 (E) ~~XXX~~
Location as "NE/CNW/SW" or footage from lines SW NE
Lease Owner Bedell-Catt Drilling Co., Inc.
Lease Name Stoltz Well No. 1
Office Address 623 Union Nat'l Bank Bldg. Wichita 2, Kansas
Character of Well (completed as Oil, Gas or Dry Hole) Dry Hole
Date well completed October 28 1954
Application for plugging filed " 1954
Application for plugging approved " 1954
Plugging commenced " 1954
Plugging completed " 1954
Reason for abandonment of well or producing formation Dry Hole

If a producing well is abandoned, date of last production _____ 19____
Was permission obtained from the Conservation Division or its agents before plugging was commenced? Yes

Name of Conservation Agent who supervised plugging of this well A. W. Hartsook, Box 524 - Eureka, Kansas
Producing formation _____ Depth to top _____ Bottom _____ Total Depth of Well 3315 Feet
Show depth and thickness of all water, oil and gas formations.

OIL, GAS OR WATER RECORDS

CASING RECORD

FORMATION	CONTENT	FROM	TO	SIZE	PUT IN	PULLED OUT
				8 5/8"	110'	None

Describe in detail the manner in which the well was plugged, indicating where the mud fluid was placed and the method or methods used in introducing it into the hole. If cement or other plugs were used, state the character of same and depth placed, from _____ feet to _____ feet for each plug set.

Filled hole with mud to 150' - set plug put 15 sacks cement
filled up and set plug within 30' - filled with 10 sacks cement

(If additional description is necessary, use BACK of this sheet)


Name of Plugging Contractor Bedell-Catt Drilling Co., Inc.
Address 623 Union Nat'l Bank Bldg., Wichita 2, Kansas

STATE OF Kansas, COUNTY OF Sedgwick, ss.
Corb S. Bedell ~~employee of owner~~ (owner ~~of property~~) of the above-described well, being first duly sworn on oath, says: That I have knowledge of the facts, statements, and matters herein contained and the log of the above-described well as filed and that the same are true and correct. So help me God.

(Signature) Corb S. Bedell
623 Union Nat'l Bank Bldg., Wichita 2, Kansas
(Address)

SUBSCRIBED AND SWORN to before me this 29th day of October, 1954.

My commission expires March 18, 1958

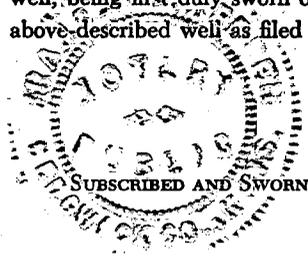

Frances L. Webber
Notary Public.

PLUGGING
FILE SEC 10 T 27 R 2E
BOOK PAGE 24 LINE 29

RECEIVED
STATE CORPORATION COMMISSION
NOV - 3 1954
11-3-54
CONSERVATION DIVISION
WICHITA, KANSAS

DRILLING LOG

Company: Bedell-Catt Drilling Co., Inc.
623 Union Nat'l Bank Bldg.
Wichita 2, Kansas

Lease: Stoltz

Well: 1

Location: SW NE of Section 10, T-27S, R 2E, Sedgwick County, Kansas

Contractor: Bedell-Catt Drilling Co., Inc.

Date Comm: October 17, 1954

Date Compl: October 28, 1954

T.D. 3315'

Production: D & A

Casing: 8 5/8" @ 110'

Figures Indicate the Bottom of Formation

0-110	Surface soil	2489	K.C. Lime
120	Hard cement	2596	Lime
200	Shale, lime & shells	2884	Shale & lime
270	Lime, shale & red bed stks	2886	Sandy lime
276	Red bed	2939	Miss lime
291	Shale & shells	2990	Lime
420	Lime & shale	3027	Cherty lime
462	Lime	3069	Lime
490	Shaled lime stks	3112	Broken lime & shale stks
646	Lime & shale		shale stks
830	Shale & lime stks	3175	Shale & lime
1185	Shale & shells	3194	Lime
1254	Lime & shale stks	3209	Core #1
1395	Shale & lime	3240	Lime
1430	Lime	Core #2	3248
1995	Shale & lime	"	3275
2058	Shale	S. Sand	3306
2180	Lime (broken)	Arbuckle	3315' T.D.
2230	Sandy lime stks		
2393	Lime & shale		
2428	Shale		

I certify the above to be true and correct to the best of my knowledge and belief.

BEDELL-CATT DRILLING CO., INC.

By Corb. S. Bedell
Corb. S. Bedell

Subscribed and sworn before me this 1st day of November, 1954.

My Commission Expires:

March 18, 1958

PLUGGING

FILE SEC 10 T 22 R 2E
BOOK PAGE 24 LINE 29

RECEIVED
STATE CORPORATION COMMISSION

NOV - 3 1954

CONFIDENTIAL