

15-173-00054-00-00

STATE OF KANSAS
STATE CORPORATION COMMISSION

WELL PLUGGING RECORD

Give All Information Completely
Make Required Affidavit
Mail or Deliver Report to:
Conservation Division
State Corporation Commission
800 Bittling Building
Wichita, Kansas

Sedgwick County, Sec. 10 Twp. 27S. Rge. 2E (E) (W)

Location as "NE/CNW $\frac{1}{4}$ SW $\frac{1}{4}$ " or footage from lines NE NE NE

Lease Owner A. D. Allison et al

Lease Name Stoltz Well No. 1

Office Address 715 Brown Building, Wichita 2, Kansas

Character of Well (completed as Oil, Gas or Dry Hole) Oil well

Date well completed 19

Application for plugging filed 4-2 19 52

Application for plugging approved 4-2 19 52


Plugging commenced 4-14 19 52

Plugging completed 4-16 19 52

Reason for abandonment of well or producing formation Dry

If a producing well is abandoned, date of last production 19

Was permission obtained from the Conservation Division or its agents before plugging was commenced? Yes

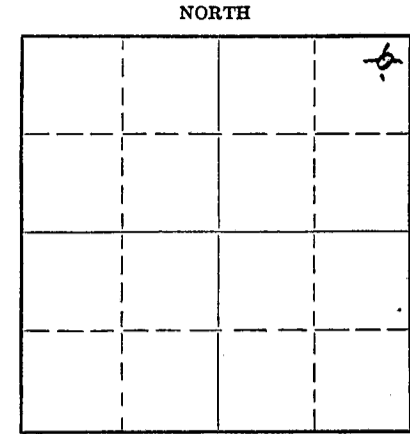

Locate well correctly on above Section Plat

Name of Conservation Agent who supervised plugging of this well D. C. Lilley

Producing formation Depth to top Bottom Total Depth of Well 3319 Feet

Show depth and thickness of all water, oil and gas formations.

OIL, GAS OR WATER RECORDS

CASING RECORD

Formation	Content	From	To	Size	Put In	Pulled Out
				8-5/8	120	none

Describe in detail the manner in which the well was plugged, indicating where the mud fluid was placed and the method or methods used in introducing it into the hole. If cement or other plugs were used, state the character of same and depth placed, from feet to feet for each plug set.

Cement to 3275. Mud from 3275 to 135. Rock from 135 to 125.

Cement 125 to 75. Mud 75 to 10. Cement 10' to surface.

(If additional description is necessary, use BACK of this sheet)

Name of Plugging Contractor A. D. Allison & Co., Inc.

Address 715 Brown Building, Wichita 2, Kansas.


STATE OF Kansas, COUNTY OF Sedgwick, ss.

J. A. ALLISON (employee of owner) or (owner or operator) of the above-described well, being first duly sworn on oath, says: That I have knowledge of the facts, statements, and matters herein contained and the log of the above-described well as filed and that the same are true and correct. So help me God.

(Signature) J. A. Allison

715 Brown Building, Wichita 2, Ks. (Address)

SUBSCRIBED AND SWORN to before me this 23 day of July, 19 52

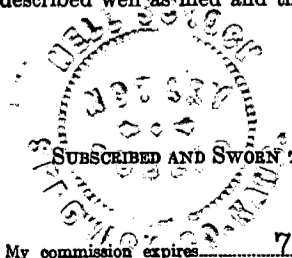

(Signature) [Signature] Notary Public.

My commission expires 7-22-53

23-8390-s 6-51-20M

JUL 24 1952
7-24-52
CONSERVATION DIVISION
Wichita, Kansas

PLUGGING
FILE SEC 10 T 27 R 26
BOOK PAGE 6 LINE 11

A. D. ALLISON ET AL
#1 STOLTZ

Sec. 10, Twp. 27S., Rge. 2E.,
Sedgwick County, Kansas.

Total Depth 3319'

Comm: 5-5-51

Comp: 5-18-51

CONTR: A. D. ALLISON & CO., INC.

NE NE NE

Elev. 1381 Gr.
1385 R. B.

PRODUCING

CASING RECORD:

8-5/8 120'

FORMATION

DEPTH

Lime and shale	275
Lime, streaks of sand	430
Shale and lime	605
Lime and shale	745
Shale and shells	1470
Lime and shale	2448
Lime (KC)	2554
Lime and shale	2746
Shale	2815
Shale and lime	2915
Lime (Miss.)	3140
Shale and lime	3200
Simpson sand	3250
Sand and shale	3265
Shale and sand	3297
Sand and shale	3300
Sand	3312
Sand and shale	3313
Lime, Arbuckle	3319 - TD

TOPS:

KC Limestone	2443
Mississippi	2906
Kinderhook	3114
Misener Sand	3200
Viola Dol.	3201
Simpson	3222
Arbuckle	3313

