

Give All Information Completely  
Make Required Affidavit  
Mail or Deliver Report to:  
Conservation Division  
State Corporation Commission  
800 Bitting Building  
Wichita, Kansas


OR

FORMATION PLUGGING RECORD

Strike out upper line  
when reporting plug-  
ging of formations.

Sedgwick County. Sec. 8 Twp. 28 Rge. 2 (E) (W)

Location as "NE $\frac{1}{4}$ NW $\frac{1}{4}$ SW $\frac{1}{4}$ " or footage from lines... NE SE RT  
Lease Owner... Falcon Seaboard  
Lease Name... Stroiff Well No. 1  
Office Address... Union National Bank Bldg., Wichita, Kansas.  
Character of Well (completed as Oil, Gas or Dry Hole) Dry  
Date well completed... Feb 9, 1944 19...  
Application for plugging filed... Feb 10, 1944 19...  
Application for plugging approved... Feb 10, 1944 19...  
Plugging commenced... Feb 15, 1944 19...  
Plugging completed... Feb 22, 1944 19...  
Reason for abandonment of well not producing formation.

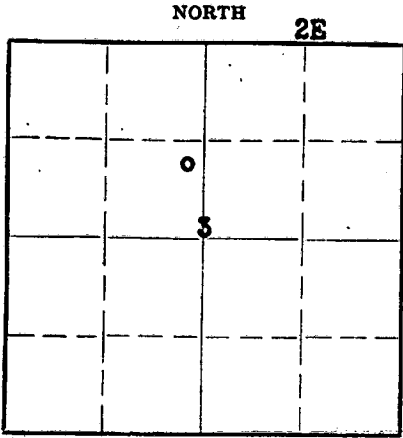

Locate well correctly on above  
Section Plat

If a producing well is abandoned, date of last production... 19...  
Was permission obtained from the Conservation Division or its agents before plugging was com-  
menced? Yes

Name of Conservation Agent who supervised plugging of this well... Raymond Williams  
Producing formation... None Depth to top... Bottom... Total Depth of Well 5340 Feet  
Show depth and thickness of all water, oil and gas formations.

OIL, GAS OR WATER RECORDS

CASING RECORD

| Formation | Content | From | To | Size | Put In | Pulled Out |
|-----------|---------|------|----|------|--------|------------|
|           |         |      |    | 160  | 120    | 120        |
|           |         |      |    | 180  | 750    | 750        |
|           |         |      |    | 10   | 2080   | 5080       |
|           |         |      |    | 62   | 2668   | 2668       |

Describe in detail the manner in which the well was plugged, indicating where the mud fluid was placed and the method or methods used in introducing it into the hold. If cement or other plugs were used, state the character of same and depth placed, from... feet to... feet for each plug set.

Filled hole with mud to 3200' - cemented to 3268' with 10 sacks - mud to 155' - put in bridge and filled with stone to 135' and cemented with 15 sacks cement - mudded to 15' and cemented to bottom of collar.

FILE 3-28-2E  
113-42


(If additional description is necessary, use BACK of this sheet)

Correspondence regarding this well should be addressed to Falcon Seaboard  
Address... Union National Bank Bldg., Wichita, Kansas.

STATE OF Kansas COUNTY OF Sedgwick, ss.  
Joe Gentry (employee of owner) or (owner or operator) of the above-described well,  
being first duly sworn on oath, says: That I have knowledge of the facts, statements, and matters herein contained and the log of the above-described well as filed and that the same are true and correct. So help me God.

(Signature) Joe Gentry  
Curka Thomas  
(Address)

SUBSCRIBED AND SWORN to before me this 23 day of February

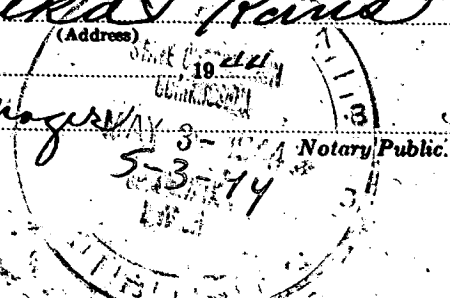

My commission expires 2-5-45


WELL LOG BUREAU - KANSAS GEOLOGICAL SOCIETY  
412 Union National Bk. Bldg., Wichita, Kansas

Company - FALCON SEABOARD DRIG.CO.  
Farm - Streiff No. 1.

SEC. 3 T. 28 R. 2 E  
NE SE NW

Total Depth. 3340'  
Comm. 12-21-43 Comp. 2-9-44  
Shot or Treated.  
Contractor. I. W. Murfin  
Issued. 3-4-44

County. Sedgwick  
KANSAS

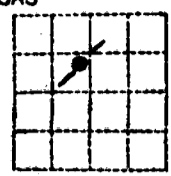

Elevation. 1361

Production. Dry

CASING:  
15 1/2" 120' P 8 1/4" 2665' P  
12 1/2" 750' P  
10" 2080' P

Figures Indicate Bottom of Formations.

|                     |      |                     |      |                         |      |
|---------------------|------|---------------------|------|-------------------------|------|
| cellar              | 10   | shale               | 1060 | Kansas City lime        | 2535 |
| clay yellow         | 47   | lime                | 1070 | lime (2BWPH 2550)       | 2630 |
| lime(5BWPH 80-85)   | 55   | shale               | 1120 | shale(more wtr 2585-95) | 2640 |
| mud blue            | 80   | lime 2BW 1133-40    | 1130 | lime (HFW 2585-2605)    | 2725 |
| lime sdy            | 95   | shale blue          | 1133 | shale                   | 2750 |
| more wtr 110-15     |      | lime                | 1155 | lime                    | 2760 |
| shale, lime, shells | 120  | shale               | 1165 | shale                   | 2788 |
| lime                | 160  | lime 1BWPH 1070     | 1170 | lime                    | 2796 |
| shale & shells      | 185  | shale sdy           | 1190 | shale                   | 2827 |
| lime                | 200  | lime                | 1200 | lime                    | 2850 |
| shale               | 240  | shale               | 1225 | shale                   | 2855 |
| lime                | 250  | lime                | 1248 | lime                    | 2860 |
| shale               | 275  | shale & shells      | 1270 | shale & shells          | 2885 |
| lime                | 285  | lime                | 1280 | shale                   | 2890 |
| shale & lime        | 290  | shale               | 1285 | lime                    | 2893 |
| lime                | 295  | lime                | 1315 | shale                   | 2903 |
| shale & shells      | 310  | shale               | 1325 | lime                    | 2906 |
| red rock            | 335  | lime                | 1330 | shale                   | 2920 |
| lime(2BWPH 445-50)  | 480  | shale               | 1340 | shale & shells          | 2950 |
| shale               | 495  | lime                | 1347 | lime                    | 2955 |
| lime                | 510  | shale               | 1355 | shale                   | 2970 |
| shale               | 520  | shale sdy           | 1400 | red rock                | 2980 |
| lime                | 570  | lime                | 1405 | shale various colored   | 2986 |
| shale               | 580  | shale, carrying 4BW | 1410 | conglomerate cherty     | 3000 |
| red rock            | 585  | lime                | 1454 | caving                  |      |
| lime                | 602  | shale               | 1465 | lime                    | 3160 |
| shale               | 607  | lime                | 1480 | lime shaly              | 3175 |
| lime                | 615  | shale               | 1500 | lime                    | 3200 |
| shale pink          | 620  | lime                | 1515 | lime brkn               | 3230 |
| lime                | 640  | shale               | 1535 | lime                    | 3252 |
| shale               | 650  | lime                | 1590 | shale lgt               | 3255 |
| lime                | 675  | shale               | 1620 | shale blk               | 3280 |
| shale               | 685  | lime                | 1640 | lime                    | 3285 |
| shale & shells      | 700  | shale               | 1650 | shale HFW 3325-40       | 3307 |
| 10BWPH 720-30       |      | shale & shells      | 1680 | sand                    | 3340 |
| lime                | 730  | lime                | 1700 | Total Depth.            |      |
| lime sdy            | 740  | shale               | 1745 |                         |      |
| shale               | 750  | lime                | 1750 |                         |      |
| lime                | 760  | shale               | 1765 |                         |      |
| shale               | 770  | lime                | 1775 |                         |      |
| lime                | 810  | shale               | 1780 |                         |      |
| shale, lime shells  | 825  | lime                | 1800 |                         |      |
| 2BWPH 855-65        |      | shale               | 1825 |                         |      |
| lime                | 875  | lime                | 1850 |                         |      |
| shale               | 880  | shale               | 1855 |                         |      |
| lime                | 900  | lime                | 1875 |                         |      |
| shale               | 905  | shale               | 1880 |                         |      |
| lime                | 920  | lime                | 1965 |                         |      |
| shale               | 955  | shale               | 1980 |                         |      |
| lime                | 965  | lime                | 1985 |                         |      |
| shale               | 985  | shale               | 2048 |                         |      |
| lime                | 990  | sand HFW 2080       | 2080 |                         |      |
| shale               | 1000 | shale               | 2135 |                         |      |
| lime                | 1005 | lime                | 2145 |                         |      |
| shale               | 1010 | shale               | 2180 |                         |      |
| lime                | 1015 | lime                | 2225 |                         |      |
| shale & shells      | 1025 | lime sft            | 2235 |                         |      |
| shale               | 1030 | shale               | 2353 |                         |      |
| lime                | 1035 | lime                | 2365 |                         |      |
| shale & shells      | 1045 | shale               | 2515 |                         |      |

Tops: K. C. 2515  
Miss. 3000  
Simpson 3307

WELL LOG BUREAU  
3-28-28  
PAGE 112 LINE 42