

15-173-00007-00-00

STATE OF KANSAS  
STATE CORPORATION COMMISSION

WELL PLUGGING RECORD

Give All Information Completely  
Make Required Affidavit  
Mail or Deliver Report to:  
Conservation Division  
State Corporation Commission  
800 Bittling Building  
Wichita, Kansas

Sedgwick County. Sec. 4 Twp. 28S Rge. 2 (E) (W)

Location as "NE/CNW%SW%" or footage from lines C E/2 SE/4 NE/4

Lease Owner Mr. J. P. Gaty

Lease Name Hurst Well No. 1

Office Address c/o Beech Aircraft Corp., Wichita, Kansas

Character of Well (completed as Oil, Gas or Dry Hole) Dry Hole

Date well completed March 2 19 53

Application for plugging filed Verbal March 1 19 53

Application for plugging approved Verbal March 1 19 53


Plugging commenced March 1 19 53

Plugging completed March 2 19 53

Reason for abandonment of well or producing formation \_\_\_\_\_

If a producing well is abandoned, date of last production \_\_\_\_\_ 19 \_\_\_\_\_

Was permission obtained from the Conservation Division or its agents before plugging was commenced? Yes

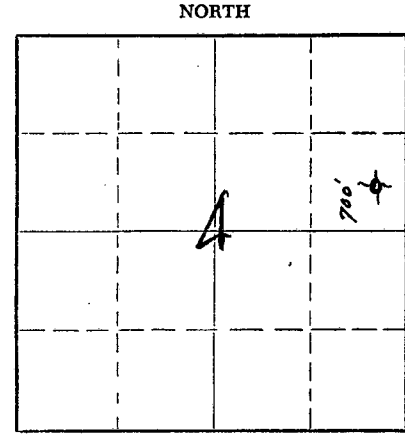

Locate well correctly on above Section Plat

Name of Conservation Agent who supervised plugging of this well Mr. J. P. Roberts, Wichita, Kansas

Producing formation \_\_\_\_\_ Depth to top \_\_\_\_\_ Bottom \_\_\_\_\_ Total Depth of Well 3080 Feet

Show depth and thickness of all water, oil and gas formations.

OIL, GAS OR WATER RECORDS

CASING RECORD

FORMATION	CONTENT	FROM	TO	SIZE	PUT IN	PULLED OUT

Describe in detail the manner in which the well was plugged, indicating where the mud fluid was placed and the method or methods used in introducing it into the hole. If cement or other plugs were used, state the character of same and depth placed, from \_\_\_\_\_ feet to \_\_\_\_\_ feet for each plug set.

Filled hole to 150' with heavy rotary mud. Set wooden bridge and cemented with 15 sax cement. Filled hole to 20' and capped with 5 sax cement.

RECEIVED  
STATE CORPORATION COMMISSION  
MAR 7 1953  
3-7-53  
CONSERVATION DIVISION  
Wichita, Kansas

(If additional description is necessary, use BACK of this sheet)

Name of Plugging Contractor Morrison Drilling Company, Inc.  
Address Drawer 712, El Dorado, Kansas

STATE OF KANSAS COUNTY OF SEDGWICK, ss.


John P. Gaty (employee of owner) or (owner or operator) of the above-described well, being first duly sworn on oath, says: That I have knowledge of the facts, statements, and matters herein contained and the log of the above-described well as filed and that the same are true and correct. So help me God.

(Signature)

(Address)

Subscribed and sworn to before me this 6th day of March, 19 53

Edna G. Hayes  
Notary Public.

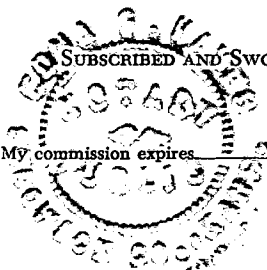

24-2675-5 2-52-20M

PLUGGING  
FILE SEC 4 T 28 R 2E  
BOOK PAGE 82 LINE 3

WELL LOG - Hurst #1

OPERATOR: Mr. J. P. Gaty  
c/o Beech Aircraft Corp.  
Wichita, Kansas

LOCATION: C E/2 SE/4 SE/4  
Section 4-289-2E  
Sedgwick County, Kansas

CONTRACTOR: Morrison Drilling Company, Inc.  
El Dorado, Kansas

PRODUCTION: D & A

FARM: Hurst Well No. 1

Date Commenced: February 22, 1953

Date Completed: March 2, 1953

Total Depth: 3080 feet - Rotary

<u>From</u>	<u>To</u>	<u>Formation</u>
45	90	Cement
90	380	Shale & Shells
380	490	Lime
490	605	Lime and Shale
605	730	Lime & Shale strks.
730	785	Shale
785	910	Shale & Lime
910	1020	Shale
1020	1530	Shale and Lime
1530	1733	Shale (sandy) & Lime Strks.
1733	1990	Shale & Lime strks.
1990	2190	Lime & Shale
2190	2225	Lime
2225	2350	Lime & Shale brks.
2350	2484	Shale & Lime strks.
2484	2490	Lime & Shale
2490	2720	Lime
2720	2730	Lime & Shale
2730	2905	Shale & Lime strks.
2905	2977	Lime & Shale
2977	3020	Miss. Lime & Shale
3020	3080	Lime
3080		Total Depth.

Tops  
Kansas City - 2502  
Mammoth - 2730  
Miss. Lime - 2978

I hereby certify that the foregoing is a true and correct copy of the Well Log for the #1 Hurst well drilled for Mr. J. P. Gaty and completed March 2, 1953.

MORRISON DRILLING COMPANY, INC.



C. W. Wilson - Secretary-Treasurer

STATE OF KANSAS )  
                          ) ss.  
COUNTY OF BUTLER )

SUBSCRIBED AND SWORN TO, Before the Undersigned, a Notary Public, in and for the County and State aforesaid this 5th day of March, 1953.



  
Notary Public

RECORDED  
STATE OF KANSAS  
MAR - 7 1953  
CONSERVATION DIVISION  
Wichita, Kansas

**PLUGGING**  
FILE SEC 4 T 28 S 2E  
BOOK PAGE 82 LINE 3