

WELL PLUGGING RECORD


Give All Information Completely
Make Required Affidavit
Mail or Deliver Report to:
Conservation Division
State Corporation Commission
800 Bittling Building
Wichita, Kansas

Butler

County. Sec. 16 Twp. 27 Rge. 3 (E) E (W)

Location as "NE/CNW $\frac{1}{4}$ SW $\frac{1}{4}$ " or footage from lines SW SE NE
Lease Owner Musgrove Petroleum Corporation, Inc.
Lease Name Belford Well No. 1
Office Address 407 K.F.H. Bldg. Wichita, Kansas
Character of Well (completed as Oil, Gas or Dry Hole) Dry Hole
Date well completed February 28, 1951 19
Application for plugging filed February 27, 1951 Verbally 19
Application for plugging approved February 27, 1951 " 19
Plugging commenced February 28, 1951 19
Plugging completed February 28, 1951 19
Reason for abandonment of well or producing formation Dry Hole

NORTH

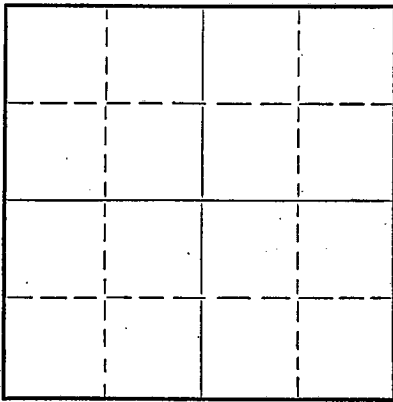

Locate well correctly on above Section Plat

If a producing well is abandoned, date of last production 19
Was permission obtained from the Conservation Division or its agents before plugging was commenced? Yes

Name of Conservation Agent who supervised plugging of this well A. L. Loman

Producing formation Depth to top Bottom Total Depth of Well 3133' Feet

Show depth and thickness of all water, oil and gas formations.

OIL, GAS OR WATER RECORDS

CASING RECORD

Formation	Content	From	To	Size	Put In	Pulled Out
				8 5/8"	275'	None

Describe in detail the manner in which the well was plugged, indicating where the mud fluid was placed and the method or methods used in introducing it into the hole. If cement or other plugs were used, state the character of same and depth placed, from feet to feet for each plug set.

Plugging Record.

Filled hole with heavy mud to 260' - Plug and bridge at 260' and 10 sacks cement. Filled hole to 40' with heavy mud - plug at 40' and 10 sacks cement.

(If additional description is necessary, use BACK of this sheet)

Correspondence regarding this well should be addressed to B & R Drilling, Inc.
Address Russell, Kansas

STATE OF Kansas, COUNTY OF Russell, ss.

W. A. Michaelis, Jr. (employee of owner) or (owner or operator) of the above-described well, being first duly sworn on oath, says: That I have knowledge of the facts, statements, and matters herein contained and the log of the above-described well as filed and that the same are true and correct. So help me God.

(Signature) W. A. Michaelis, Jr.

Russell, Kansas (Address)

SUBSCRIBED AND SWORN to before me this 12th day of March, 1951

My commission expires 6-17-54

23-5091-s 8-50-10M

Notary Public.

3/14/51
MAR 14 1951

CONSERVATION DIVISION
Wichita, Kansas



PLUGGING
FILE SEC-16-T-27-R-3E
PAGE 65 LINE 76

15-015-00629-00-00

MUSGROVE PETROLEUM CORP.
BELFORD # 1

SW SE NE Sec. 16-27-3
BUTLER COUNTY, KANSAS

Total Depth: 3133'
Comm: 2-16-51
Comp: 2-28-51

Casing

8 5/8" Set @ 275'

Cement

125 sacks of Red Seal

Formation	Depth:
Shale-Lime	275
Lime	355
Lime-Shale	420
Lime-Chert	535
Lime	700
Lime-Shale	1830
Shale-Sand	1885
Lime-Shale	1925
Lime-Shale-Sand	1992
Lime-Shale	2363
Lime	2442
Lime-Shale	2454
Lime	2468
Lime-Chert	2502
Lime-Shale	2788
Lime-Chert-Shale	2848
Lime	2852
Chert-Lime	2937
Lime	3037
Shale	3081
Shale-Lime	3101
Shale-Lime-Sand	3109
Shale-Sand	3133

STATE OF KANSAS)
)SS
RUSSELL COUNTY)

I hereby certify that the above information is true
and correct to the best of my knowledge.

Violet Keller

Subscribed and sworn to before me this 9th day of March, 1951.

Chas. L. Hummel
Notary Public

My commission expires: 6-17-54

PLUGGING
FILE SEC. 16T-27R-3E
BOOK PAGE 65 LINE 26