

CARD MUST BE TYPED

State of Kansas
NOTICE OF INTENTION TO DRILL
(see rules on reverse side)

CARD MUST BE SIGNED

Starting Date:7-19-85.....
month day year

OPERATOR: License # 5516
Name Central Plains Energy Exploration
Address P. O. Box 433
City/State/Zip Cherryvale, KS 67335
Contact Person Bill Bungarner
Phone (316) 336-2140

CONTRACTOR: License # 9960
Name Tinnon Bros. Drilling
City/State Nowata, Okla

Well Drilled For: Well Class: Type Equipment:

☒ Oil	☐ Swd	☒ Infield	☐ Mud Rotary
☒ Gas	☐ Inj	☐ Pool Ext.	☒ Air Rotary
☐ OWWO	☐ Expl	☐ Wildcat	☐ Cable

If OWWO: old well info as follows:

Operator

Well Name

Comp Date Old Total Depth

Projected Total Depth 900 feet

Projected Formation at TD.....Mississippi.....

Expected Producing Formations Mississippi.....

API Number 15- 099-22,346-0000
~~NE NE NW~~ NE ☒ East
 (location) ... Sec. 1 ... Twp 34 ... S, Rge 17 ... ☐ West

...4950..... **Ft North from Southeast Corner of Section**

.....990..... Ft West from Southeast Corner of Section

(Note: Locate well on Section Plat on reverse side)

Nearest lease or unit boundary line330..... feet.

CountyLabette.....

Lease NameHenry..... Well#4.....

Domestic well within 330 feet : ☐ yes ☒ no

Municipal well within one mile : ☐ yes ☒ no

Depth to Bottom of fresh water 40 feet

Lowest usable water formation Unknown

Depth to Bottom of usable water.....100..... feet

Surface pipe by Alternate : 1 ☐ 2 ☒

Surface pipe to be set, 20 **feet**

Conductor pipe if any required None feet

Ground surface elevation Unknown **feet MSL**

This Authorization Expires 11-86 2

Approved By 7-11-85 *[Signature]*

I certify that we will comply with K.S.A. 55-101, et seq., plus eventually plugging hole to K.C.C. specifications.

Date 7/11/85 Signature of Operator or Agent [Signature] Title Agent

RECEIVED
STATE CORPORATION COMMISSION

Must be filed with the K.C.C. five (5) days prior to commencing well
This card void if drilling not started within six (6) months of date received by K.C.C.

1111 11 1985


7-11-85

CONSERVATION DIVISION

Wichita, Kansas

A Regular Section of Land

1 Mile = 5,280 Ft.

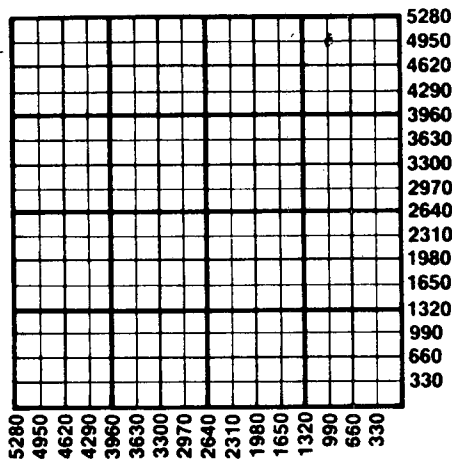

Important procedures to follow :

1. Notify District office before setting surface casing.
2. Set surface casing by circulating cement to the top.
3. File completion forms ACO-1 with K.C.C. within 90 days of well completion, following instructions on ACO-1, side 1, and including copies of wireline logs.
4. Notify District office 48 hours prior to old well workover or re-entry.
5. Prior to plugging, prepare a plugging plan, then obtain agreement from the appropriate district office for an approved plugging plan.
6. Submit plugging report (CP-4) to K.C.C. after plugging is completed.
7. Obtain an approved injection docket number before disposing of salt water.
8. Notify K.C.C. within 10 days when injection commences or terminates.
9. If an alternate 2 completion, cement in the production pipe from below any usable water to surface within 120 days of spud date.

State Corporation Commission of Kansas
Conservation Division
200 Colorado Derby Building
Wichita, Kansas 67202
(316) 263-3238