

CARD MUST BE TYPED

State of Kansas NOTICE OF INTENTION TO DRILL

CARD MUST BE SIGNED

(see rules on reverse side)

Starting Date: December 12 1984
month day year

API Number 15- 099-22,240-00-00

OPERATOR: License # 5516
Name Central Plains Energy Exploration
Address Box 433
City/State/Zip Cherryvale, KS 67335
Contact Person Bill Bungarner
Phone (316) 336-2148

SE NW/4, NE/4 Sec 6 Twp 34 S, Rge 18 East West
(location)

4290 Ft North from Southeast Corner of Section
221650 Ft West from Southeast Corner of Section
(Note: Locate well on Section Plat on reverse side)

CONTRACTOR: License # ~~178~~ 9605
Name Rusty's Drilling
City/State P.O. Box 260 Chanute, KS 66720

Nearest lease or unit boundary line 990 feet.
County Labette
Lease Name Summers Well# 2

Well Drilled For: Well Class: Type Equipment:
 Oil Swd Infield Mud Rotary
 Gas Inj Pool Ext. Air Rotary
 OWWO Expl Wildcat Cable

Domestic well within 330 feet: yes no
Municipal well within one mile: yes no

If OWWO: old well info as follows:

Operator
Well Name
Comp Date Old Total Depth
Projected Total Depth 1000 feet
Projected Formation at TD Mississippi
Expected Producing Formations Mississippi

Depth to Bottom of fresh water 40 feet
Lowest usable water formation 150
Depth to Bottom of usable water 150/100 feet
Surface pipe by Alternate: 1 2
Surface pipe to be set 20 feet
Conductor pipe if any required None feet
Ground surface elevation Unknown feet MSL
This Authorization Expires 6-10-85
Approved By 10-12-84

I certify that we will comply with K.S.A. 55-101, et seq., plus eventually plugging hole to K.C.C. specifications.

Date 12/12/84 Signature of Operator or Agent [Signature]

Title Sec. Agent

mhc / NOTE 12/10/84

Must be filed with the K.C.C. five (5) days prior to commencing well
This card void if drilling not started within six (6) months of date received by K.C.C.


12-10-84

RECEIVED
STATE CORPORATION COMMISSION

Important procedures to follow:

DEC 10 1984

A Regular Section of Land
1 Mile = 5,280 Ft.

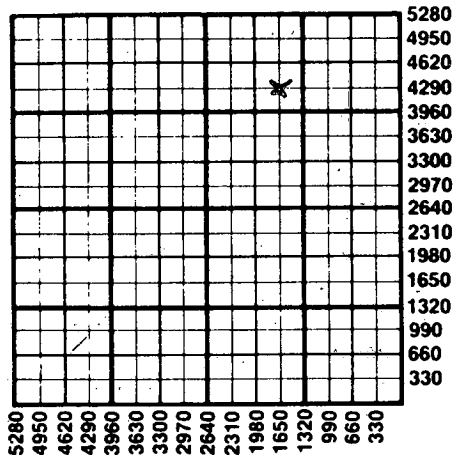

1. Notify District office before setting surface casing.
2. Set surface casing by circulating cement to the top of the well, Kansas
3. File completion forms ACO-1 with K.C.C. within 90 days of well completion, following instructions on ACO-1, side 1, and including copies of wireline logs.
4. Notify District office 48 hours prior to old well workover or re-entry.
5. Prior to plugging, prepare a plugging plan, then obtain agreement from the appropriate district office for an approved plugging plan.
6. Submit plugging report (CP-4) to K.C.C. after plugging is completed.
7. Obtain an approved injection docket number before disposing of salt water.
8. Notify K.C.C. within 10 days when injection commences or terminates.
9. If an alternate 2 completion, cement in the production pipe from below any usable water to surface within 120 days of spud date.

State Corporation Commission of Kansas
Conservation Division
200 Colorado Derby Building
Wichita, Kansas 67202
(316) 263-3238