
NOTICE OF INTENTION TO DRILL

(see rules on reverse side)

Expected Spud Date. 7. 29 - 1987 month day year	API Number 15— 107 - 22,88-3 X East
OPERATOR: License # 6.15.7.	.S., E., Sec 3., Twp. 20 s, Rg. 23 West
Name J & J Oil Company	7.30 ! Ft. from South Line of Section
Address BOX 298	990 1 Ft. from East Line of Section
City/State/Zip Mound City Kansas 66056	(Note: Locate well on Section Plat on reverse side)
Contact Person. Paul Jackson	Nearest lease or unit boundary line .3.30 feet
Phone 913 795 2586	County. Linn
CONTRACTOR: License # 6157	Lease Name Teagarden Well # C-7
Name Company Tools	Ground surface elevation . N/A feet MSL
City/State Mound City Kansas 66056	Domestic well within 330 feet:yes Xno
Well Drilled For: Well Class: Type Equipment:	Municipal well within one mile:yes X_no
Oil Storage X Infield X Mud Rotary	Depth to bottom of fresh water. 60
Gas X Inj Pool Ext Air Rotary	Depth to bottom of usable water150
OWWO Expl Wildcat Cable	Surface pipe by Alternate: 1 2 X
If OWWO: old well info as follows:	Surface pipe planned to be set 21!
Operator	Conductor pipe required NOILE
Well Name	Projected Total Depthfeet
Comp Date Old Total Depth	Formation Perù
I certify that well will comply with K.S.A. 55-101, et seq., plus entua	fly plugging hole to KCC specifications.
Date7-20-1987 Signature of Operator or Agent 7. aud.	Title Owner
For KCC Use:	20 40
Conductor Pipe Required	e Required feet per Alt. (2)
This Authorization Expires	Approved By Put 7-24-87

Must be filed with the K.C.C. five (5) days prior to commencing well This card void if drilling not started within six (6) months of date received by K.C.C.

Important procedures to follow:

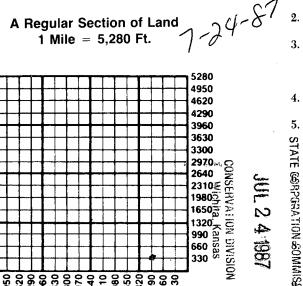

- 1. Notify District office before setting surface casing.
- 2. Set surface casing by circulating cement to the top.
- 3. File completion forms ACO-1 with K.C.C. within 120 days of well spud date, following instructions on ACO-1, side 1, and including copies of wireline logs.
- 4. Notify District office 48 hours prior to old well workover or re-entry.
- 5. Prior to filing Intent, prepare a proposed plugging plan in case well is D & A, then obtain approval of plan when calling district office prior to setting surface pipe.

Submit plugging report (CP-4) to K.C.C. after plugging is completed.

Obtain an approved injection docket number before disposing of salt

Notify nates. Notify K.C.C. within 10 days when injection commences or termi-

If an alternate 2 completion, cement in the production pipe from below any usable water to surface within 120 days of spud date.

> State Corporation Commission of Kansas Conservation Division 200 Colorado Derby Building Wichita, Kansas 67202-1212 (316) 263-3238