

CARD MUST BE TYPED

State of Kansas

CARD MUST BE SIGNED

NOTICE OF INTENTION TO DRILL

(see rules on reverse side)

Expected Spud Date. 8-3-1987
month day year

API Number 15- 107-22,890-00-00 East

OPERATOR: License # 6157
Name J. & J. Oil Company
Address Box 298
City/State/Zip Mound city Kansas 66056
Contact Person Paul Jackson
Phone 913 795 2586

S. E. 1/4 Sec. 3 Twp 20 S, Rg. 23 West
495 Ft. from South Line of Section
1.155 Ft. from East Line of Section

(Note: Locate well on Section Plat on reverse side)

CONTRACTOR: License # 6157
Name Company Tools
City/State Mound City Kansas 66056

Nearest lease or unit boundary line 495 feet
County Linn
Lease Name Teagarden Well # D-8

Well Drilled For: Well Class: Type Equipment:
 Oil Storage Infield Mud Rotary
 Gas Inj Pool Ext. Air Rotary
 OWWO Expl Wildcat Cable

Ground surface elevation N/A feet MSL
Domestic well within 330 feet: yes no
Municipal well within one mile: yes no

If OWWO: old well info as follows:

Operator
Well Name
Comp Date Old Total Depth

Depth to bottom of fresh water 60'
Depth to bottom of usable water 150'
Surface pipe by Alternate: 1 2
Surface pipe planned to be set 21'
Conductor pipe required None
Projected Total Depth 236 feet
Formation Peru

I certify that well will comply with K.S.A. 55-101, et seq. plus eventually plugging hole to KCC specifications.

Date 7-24-1987 Signature of Operator or Agent Paul Jackson Title Owner

For KCC Use:

Conductor Pipe Required _____ feet; Minimum Surface Pipe Required 20 feet per Alt. 2
This Authorization Expires 1-27-88 Approved By PH 7-27-87


Must be filed with the K.C.C. five (5) days prior to commencing well
This card void if drilling not started within six (6) months of date received by K.C.C.

Important procedures to follow:

A Regular Section of Land
1 Mile = 5,280 Ft.

7-27-87

1. Notify District office before setting surface casing.
2. Set surface casing by circulating cement to the top.
3. File completion forms ACO-1 with K.C.C. within 120 days of well spud date, following instructions on ACO-1, side 1, and including copies of wireline logs.
4. Notify District office 48 hours prior to old well workover or re-entry.
5. Prior to filing Intent, prepare a proposed plugging plan in case well is D & A, then obtain approval of plan when calling district office prior to setting surface pipe.
6. Submit plugging report (CP-4) to K.C.C. after plugging is completed.
7. Obtain an approved injection docket number before disposing of salt water.
8. Notify K.C.C. within 10 days when injection commences or terminates.
9. If an alternate 2 completion, cement in the production pipe from below any usable water to surface within 120 days of spud date.

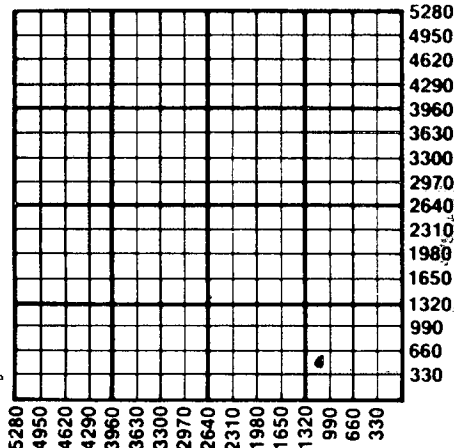

Wichita, Kansas
CONSERVATION DIVISION

JUL 27 1987
STATE CORPORATION COMMISSION

State Corporation Commission of Kansas
Conservation Division
200 Colorado Derby Building
Wichita, Kansas 67202-1212
(316) 263-3238