

NOTICE OF INTENTION TO DRILL

(see rules on reverse side)

✓(SW)

Expected Spud Date... 5 10 88 month day year

API Number 15— 065-22,455-00-00

OPERATOR: License # 7973 Name Al-La-Lyn Oil, Inc. Address 614 W. 10th City/State/Zip Ellis, KS 67637 Contact Person Richard Romine Phone 913-737-4260

SW/4 Sec. 12 Twp. 9S S, Rg. 21W East West Ft. from South Line of Section 710 Ft. from East Line of Section 4320

(Note: Locate well on Section Plat on reverse side)

CONTRACTOR: License # 5302 Name Red Tiger Drilling Co. City/State Wichita, KS 67202

Nearest lease or unit boundary line 330 feet County Graham Lease Name Knipp Well # 3

Well Drilled For: Well Class: Type Equipment: Oil Storage Infield Mud Rotary Gas Inj Pool Ext Air Rotary OWWO Expl Wildcat Cable

Ground surface elevation 2136 feet MSL Domestic well within 330 feet: yes X no Municipal well within one mile: yes X no

If OWWO: old well info as follows: Operator Well Name Comp Date Old Total Depth

Depth to bottom of fresh water 100 Depth to bottom of usable water 900 Surface pipe by Alternate: 1 2 X Surface pipe planned to be set 200 Conductor pipe required N/A Projected Total Depth 3700 feet Formation ARB

I certify that well will comply with K.S.A. 55-101, et seq. Date 5-6-88 Signature of Operator or Agent

Henry A. Anglin

BY RED TIGER DRILLING CO.

For KCC Use: Conductor Pipe Required feet; Minimum Surface Pipe Required 200 feet per Alt. This Authorization Expires 11-6-88 Approved By RCH 5-6-88


EFFECTIVE DATE: 5-11-88

Must be filed with the K.C.C. five (5) days prior to commencing well
This card void if drilling not started within six (6) months of date received by K.C.C.

Important procedures to follow:

1. Notify District office before setting surface casing.
 2. Set surface casing by circulating cement to the top.
 3. File completion forms ACO-1 with K.C.C. within 120 days of well spud date, following instructions on ACO-1, side 1, and including copies of wireline logs.
 4. Notify District office 48 hours prior to old well workover or re-entry.
 5. Prior to filing Intent, prepare a proposed plugging plan in case well is D & A, then obtain approval of plan when calling district office prior to setting surface pipe.
 6. Submit plugging report (CP-4) to K.C.C. after plugging is completed.
 7. Obtain an approved injection docket number before disposing of salt water.
- Notify K.C.C. within 10 days when injection commences or terminates.
- alternate 2 completion, cement in the production pipe from below any usable water to surface within 120 days of spud date.

A Regular Section of Land 1 Mile = 5,280 Ft.

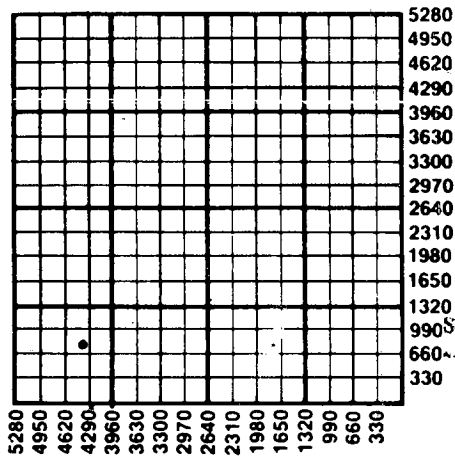

RECEIVED
STATE CORPORATION COMMISSION
5/6/88
MAY 06 1988
CONSERVATION DIVISION
Wichita, Kansas

State Corporation Commission of Kansas
Conservation Division
200 Colorado Derby Building
Wichita, Kansas 67202-1212
(316) 263-3238