

CARD MUST BE TYPED

State of Kansas
NOTICE OF INTENTION TO DRILL

(see rules on reverse side)

CORRECTION
CARD MUST BE SIGNED 5-28-85
AMENDED - LOCATION

Starting Date: ~~Drilled~~ ³ 26 ⁸⁵ 85
month day year

API Number 15-065-22,158-~~20-00~~ CORRECTION

OPERATOR: License # 5916
Name Conoco Inc.
Address 3817 NW Expressway
City/State/Zip Okla. City, OK. 73112
Contact Person Hal Roegner
Phone (405) 948-3234

* SW NE NW NE ... Sec 15 Twp 9 S, Rge 21. East West
(location)

* 4780 Ft North from Southeast Corner of Section
* 1832 Ft West from Southeast Corner of Section
(Note: Locate well on Section Plat on reverse side)

CONTRACTOR: License #
Name
City/State

Nearest lease or unit boundary line 330 feet.
County GRAHAM

Lease Name Q. E. Trexler Well# 16

Well Drilled For: Well Class: Type Equipment:
 OH Swd Infield Mud Rotary
 Gas Inj Pool Ext. Air Rotary
 OWWO Expl Wildcat Cable

Domestic well within 330 feet : yes no
Municipal well within one mile : yes no

If OWWO: old well info as follows:

Operator
Well Name
Comp Date Old Total Depth
Projected Total Depth 4100' feet
Projected Formation at TD Granite Wash Top
Expected Producing Formations Arbuckle Top (Dolo Lime)

Depth to Bottom of fresh water feet
Lowest usable water formation Dakota
Depth to Bottom of usable water 925' feet
Surface pipe by Alternate: 1 2
Surface pipe to be set 1000 feet
Conductor pipe if any required feet
Ground surface elevation feet MSL
This Authorization Expires 9-14-85
Approved By 3-14-85

I certify that we will comply with K.S.A. 55-101, et seq., plus eventually plugging hole to K.C.C. specifications.


* was: E/2 NW NE 4620 FSL
1650 FEL
Conservation Coordinator
Form C-1 4/84

Date 5-23-85 Signature of Operator or Agent

Christopher J. Dodson
Christopher J. Dodson Title

Must be filed with the K.C.C. five (5) days prior to commencing well
 This card void if drilling not started within six (6) months of date received by K.C.C.

A Regular Section of Land
1 Mile = 5,280 Ft.

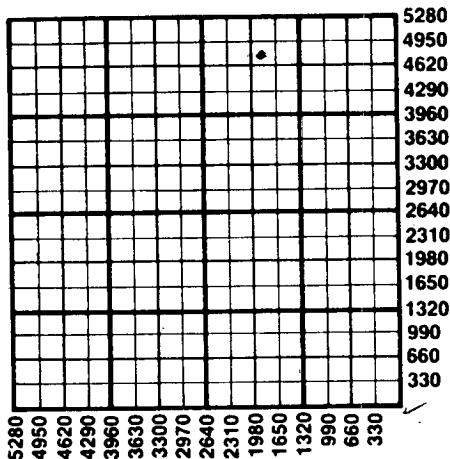

Important procedures to follow:

1. Notify District office before setting surface casing.
2. Set surface casing by circulating cement to the top.
3. File completion forms ACO-1 with K.C.C. within 90 days of well completion, following instructions on ACO-1, side 1, and including copies of wireline logs.
4. Notify District office 48 hours prior to old well workover or re-entry.
5. Prior to plugging, prepare a plugging plan, then obtain agreement from the appropriate district office for an approved plugging plan.
6. Submit plugging report (CP-4) to K.C.C. after plugging is completed.
7. Obtain an approved injection docket number before disposing of salt water.
8. Notify K.C.C. within 10 days when injection commences or terminates.
9. If an alternate 2 completion, cement in the production pipe from below any usable water to surface within 120 days of spud date.

RECEIVED
 STATE CORPORATION COMMISSION
 5/28/85
 MAY 28 1985
 CONSERVATION DIVISION
 Wichita, Kansas

State Corporation Commission of Kansas
 Conservation Division
 200 Colorado Derby Building
 Wichita, Kansas 67202
 (316) 263-3238