

NOTICE OF INTENTION TO DRILL

(see rules on reverse side)

Starting Date 3 month 28 day 86 year 2:12

API Number 15- 099-22,457-0000 ✓

OPERATOR: License # 4870
Name Thomas A. Lauth
Address 1449 Palace Avenue
City/State/Zip St. Paul, Minnesota 55105
Contact Person Thomas Lauth
Phone 612-690-2036

SW SW SE Sec. 26 Twp. 34 S, Rg. 20
330
2310
Ft. from South Line of Section
Ft. from East Line of Section

(Note: Locate well on Section Plat on reverse side)

CONTRACTOR: License # 5379
Name Kephart Drilling, Inc.
City/State R.1 Box 68A Thayer, Ks. 66776

Nearest lease or unit boundary line 330 feet
County Labette
Lease Name Bogle Well # JL-7

Well Drilled For: Well Class: Type Equipment:
Oil SWD Infield Mud Rotary
X Gas Inj. Pool Ext. X Air Rotary
OWWO Expl X Wildcat Cable

Ground surface elevation feet MSL
Domestic well within 330 feet: yes X no
Municipal well within one mile: yes X no
Depth to bottom of fresh water 20
Depth to bottom of usable water 100
Surface pipe by Alternate: 1 2 X
Surface pipe planned to be set 20
Conductor pipe required
Projected Total Depth 500 feet
Formation mississippi

If OWWO: old well info as follows:
Operator
Well Name
Comp Date Old Total Depth

I certify that well will comply with K.S.A. 55-101, et seq., plus eventually plugging hole to KCC specifications.
Date 3-28-86 Signature of Operator or Agent Wona Elmore Title as agent


For KCC Use:
Conductor Pipe Required feet; Minimum Surface Pipe Required 20 feet per Alt. 2
This Authorization Expires 3-28-86 Approved By

Must be filed with the K.C.C. five (5) days prior to commencing well  
This card void if drilling not started within six (6) months of date received by K.C.C.

### Important procedures to follow:

1. Notify District office before setting surface casing.
2. Set surface casing by circulating cement to the top.
3. File completion forms ACO-1 with K.C.C. within 90 days of well completion, following instructions on ACO-1, side 1, and including copies of wireline logs.
4. Notify District office 48 hours prior to old well workover or re-entry.
5. Prior to filing Intent, prepare a proposed plugging plan in case well is D & A, then obtain approval of plan when calling district office prior to setting surface pipe.
6. Submit plugging report (CP-4) to K.C.C. after plugging is completed.
7. Obtain an approved injection docket number before disposing of salt water.
8. Notify K.C.C. within 10 days when injection commences or terminates.
9. If an alternate 2 completion, cement in the production pipe from below any usable water to surface within 120 days of spud date.

### A Regular Section of Land 1 Mile = 5,280 Ft.

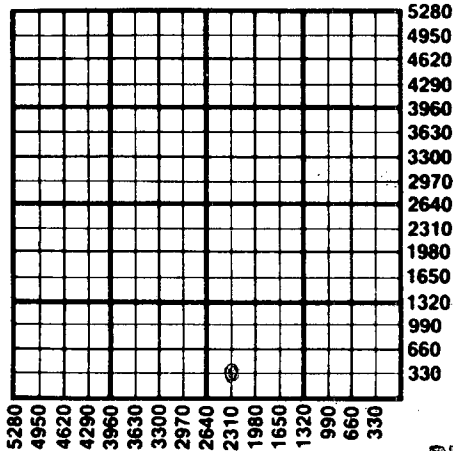

3-28-86

RECEIVED  
STATE CORPORATION COMMISSION

MAR 28 1986

CONSERVATION DIVISION

State Corporation Commission of Kansas  
Conservation Division  
200 Colorado Derby Building  
Wichita, Kansas 67202  
(316) 263-3238