

CARD MUST BE TYPED

State of Kansas

CARD MUST BE SIGNED

NOTICE OF INTENTION TO DRILL

(see rules on reverse side)

Expected Spud Date.....5/7/88.....
month day year

OPERATOR: License # ~~3288~~ 3328
 Name Central States Oil & Gas, Inc.
 Address P.O. Box 129
 City/State/Zip Cherryvale, Ks. 67335
 Contact Person Cindy Van Dyke
 Phone 316-336-3109

CONTRACTOR: License # unknown
 Name
 City/State

Well Drilled For:	Well Class:	Type Equipment:
— Oil	☒ Infield	— Mud Rotary
☒ Gas	— Pool Ext.	☒ Air Rotary
— OWWO	— Wildcat	— Cable
— Storage		
— Inj		
— Expl		

If OWWO: old well info as follows:

Operator
 Well Name
 Comp Date Old Total Depth

I certify that well will comply with K.S.A. 55-101, et seq., plus eventually plugging hole to KCC specifications.

Date 5/2/88 Signature of Operator or Agent Cindy Van Dyke Title Geologist

For KCC Use:

Conductor Pipe Required feet; Minimum Surface Pipe Required feet per Alt. X (2)
 This Authorization Expires 11-4-88 Approved By 214 5-4-88

API Number 15—099-22,673-00-00
 NE NE NW Sec 7 Twp 34 S, Rg 18 ☒ East
 4290 Ft. from South Line of Section
 990 Ft. from East Line of Section

(Note: Locate well on Section Plat on reverse side)

Nearest lease or unit boundary line 990 feet
 County Labette
 Lease Name Reedy Well # 7-1
 Ground surface elevation n/a feet MSL
 Domestic well within 330 feet: —yes ☒ no
 Municipal well within one mile: —yes ☒ no
 Depth to bottom of fresh water 100
 Depth to bottom of usable water n/a 100
 Surface pipe by Alternate: 1 2 ☒
 Surface pipe planned to be set 20
 Conductor pipe required
 Projected Total Depth 900 feet
 Formation Mississippi

EFFECTIVE DATE: 5-9-88

Must be filed with the K.C.C. five (5) days prior to commencing well
This card void if drilling not started within six (6) months of date received by K.C.C.

Important procedures to follow:


1. Notify District office before setting surface casing.
2. Set surface casing by circulating cement to the top.
3. File completion forms ACO-1 with K.C.C. within 120 days of well spud date, following instructions on ACO-1, side 1, and including copies of wireline logs.
4. Notify District office 48 hours prior to old well workover or re-entry.
5. Prior to filing Intent, prepare a proposed plugging plan in case well is D & A, then obtain approval of plan when calling district office prior to setting surface pipe.
6. Submit plugging report (CP-4) to K.C.C. after plugging is completed.
7. Obtain an approved injection docket number before disposing of salt water.

Notify K.C.C. within 10 days when injection commences or terminates.

an alternate 2 completion, cement in the production pipe from below any usable water to surface within 120 days of spud date.

State Corporation Commission of Kansas
Conservation Division
200 Colorado Derby Building
Wichita, Kansas 67202-1212
(316) 263-3238

A Regular Section of Land 1 Mile = 5,280 Ft.

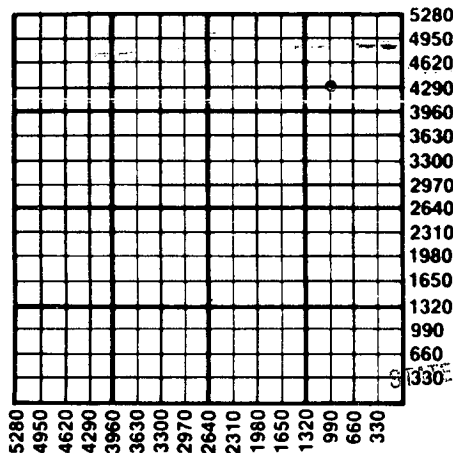

RECEIVED

STATE CORPORATION COMMISSION

MAY 04 1989

CONSERVATION DIVISION
Wichita, Kansas

5-4-89