

For KCC Use: 5-3-08
 Effective Date: 4
 District # _____
 SGA? Yes No

KANSAS CORPORATION COMMISSION
 OIL & GAS CONSERVATION DIVISION

Form C-1
 October 2007
 Form must be Typed
 Form must be Signed
 All blanks must be Filled

NOTICE OF INTENT TO DRILL

Must be approved by KCC five (5) days prior to commencing well

Expected Spud Date: May 5 2008
month day year

OPERATOR: License# 34117
 Name: Eternity Exploration, Inc.
 Address 1: 901 Lavaca Trail
 Address 2: _____
 City: Colleyville State: TX Zip: 76034 + _____
 Contact Person: Carlo Ugolini
 Phone: (316)371-5351
 CONTRACTOR: License# 33575
 Name: WW Drilling, LLC

Spot Description: Approx. NW SE NW
 SE NW SE NW Sec. 2 Twp. 10 S. R. 26 E W
(0/0/0/0) 3,432 feet from S Line of Section
1,584 feet from W Line of Section

Is SECTION: Regular Irregular?
 (Note: Locate well on the Section Plat on reverse side)

County: Sheridan
 Lease Name: Werth Well #: 1
 Field Name: Custer Northwest

Is this a Prorated / Spaced Field? Yes No
 Target Formation(s): LKC

Nearest Lease or unit boundary line (in footage): 792
 Ground Surface Elevation: 2590 feet MSL

Water well within one-quarter mile: Yes No
 Public water supply well within one mile: Yes No

Depth to bottom of fresh water: 50 feet
 Depth to bottom of usable water: 150 feet 1350'

Surface Pipe by Alternate: I II
 Length of Surface Pipe Planned to be set: 210'

Length of Conductor Pipe (if any): NA
 Projected Total Depth: 4100
 Formation at Total Depth: BKC

Water Source for Drilling Operations:
 Well Farm Pond Other:

DWR Permit #: _____
 (Note: Apply for Permit with DWR)

Will Cores be taken? Yes No
 If Yes, proposed zone: _____

Well Drilled For: Oil Gas Seismic; # of Holes _____
 Enh Rec Storage Disposal
 Other: _____
 Well Class: Infield Pool Ext. Wildcat Other
 Type Equipment: Mud Rotary Air Rotary Cable

If OWWO: old well information as follows:
 Operator: NA
 Well Name: NA
 Original Completion Date: NA Original Total Depth: NA

Directional, Deviated or Horizontal wellbore? Yes No
 If Yes, true vertical depth: NA
 Bottom Hole Location: NA
 KCC DKT #: NA

AFFIDAVIT

RECEIVED
 KANSAS CORPORATION COMMISSION

APR 28 2008

CONSERVATION DIVISION
 WICHITA, KS

The undersigned hereby affirms that the drilling, completion and eventual plugging of this well will comply with K.S.A. 55 et. seq.
 It is agreed that the following minimum requirements will be met:

1. Notify the appropriate district office **prior** to spudding of well;
2. A copy of the approved notice of intent to drill **shall be** posted on each drilling rig;
3. The minimum amount of surface pipe as specified below **shall be set** by circulating cement to the top; in all cases surface pipe shall be set through all unconsolidated materials plus a minimum of 20 feet into the underlying formation.
4. If the well is dry hole, an agreement between the operator and the district office on plug length and placement is necessary **prior to plugging**;
5. The appropriate district office will be notified before well is either plugged or production casing is cemented in;
6. If an ALTERNATE II COMPLETION, production pipe shall be cemented from below any usable water to surface within **120 DAYS** of spud date. Or pursuant to Appendix "B" - Eastern Kansas surface casing order #133,891-C, which applies to the KCC District 3 area, alternate II cementing must be completed within 30 days of the spud date or the well shall be plugged. **In all cases, NOTIFY district office** prior to any cementing.

I hereby certify that the statements made herein are true and correct to the best of my knowledge and belief.

Date: 4/25/08 Signature of Operator or Agent: [Signature] Title: Consulting Geologist

For KCC Use ONLY
 API # 15 - 179-21197-0000
 Conductor pipe required None feet
 Minimum surface pipe required 200 feet per ALT. I II
 Approved by: [Signature] 4-28-08
 This authorization expires: 4-28-09
 (This authorization void if drilling not started within 12 months of approval date.)
 Spud date: _____ Agent: _____

Remember to:

- File Drill Pit Application (form CDP-1) with Intent to Drill;
- File Completion Form ACO-1 within 120 days of spud date;
- File acreage attribution plat according to field proration orders;
- Notify appropriate district office 48 hours prior to workover or re-entry;
- Submit plugging report (CP-4) after plugging is completed (within 60 days);
- Obtain written approval before disposing or injecting salt water.
- If this permit has expired (See: authorized expiration date) please check the box below and return to the address below.

Well Not Drilled - Permit Expired Date: _____
 Signature of Operator or Agent: _____

2
10
26
 E
 W

IN ALL CASES PLOT THE INTENDED WELL ON THE PLAT BELOW

Plat of acreage attributable to a well in a prorated or spaced field

If the intended well is in a prorated or spaced field, please fully complete this side of the form. If the intended well is in a prorated or spaced field complete the plat below showing that the well will be properly located in relationship to other wells producing from the common source of supply. Please show all the wells and within 1 mile of the boundaries of the proposed acreage attribution unit for gas wells and within 1/2 mile of the boundaries of the proposed acreage attribution unit for oil wells.

API No. 15 - 179-2197-0000
 Operator: Eternity Exploration, Inc.
 Lease: Werth
 Well Number: 1
 Field: Custer Northwest

Number of Acres attributable to well: 160
 QTR/QTR/QTR/QTR of acreage: SE - NW - SE - NW

Location of Well: County: Sheridan
3,432 feet from N / S Line of Section
1,584 feet from E / W Line of Section
 Sec. 2 Twp. 10 S. R. 26 E W


Is Section: Regular or Irregular

If Section is irregular, locate well from nearest corner boundary.

Section corner used: NE NW SE SW


PLAT

*(Show location of the well and shade attributable acreage for prorated or spaced wells.)
 (Show footage to the nearest lease or unit boundary line.)*

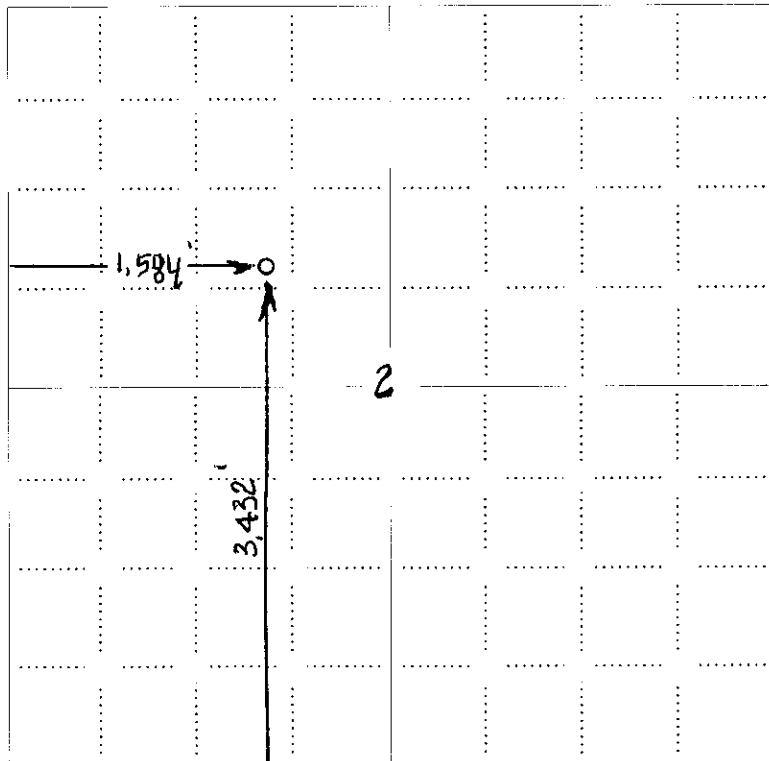

NOTE: In all cases locate the spot of the proposed drilling location.

RECEIVED
 KANSAS CORPORATION COMMISSION
APR 28 2008
 CONSERVATION DIVISION
 WICHITA, KS

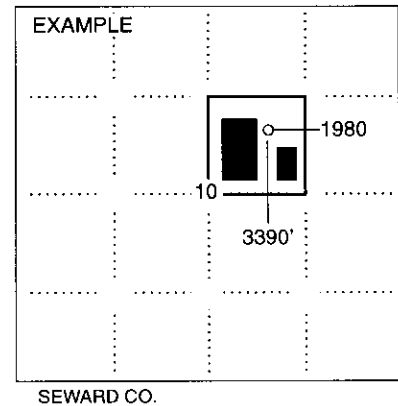

In plotting the proposed location of the well, you must show:


1. The manner in which you are using the depicted plat by identifying section lines, i.e. 1 section, 1 section with 8 surrounding sections, 4 sections, etc.
2. The distance of the proposed drilling location from the south / north and east / west outside section lines.
3. The distance to the nearest lease or unit boundary line (in footage).
4. If proposed location is located within a prorated or spaced field a certificate of acreage attribution plat must be attached: (C0-7 for oil wells; CG-8 for gas wells).

KANSAS CORPORATION COMMISSION
OIL & GAS CONSERVATION DIVISION

Form CDP-1
April 2004
Form must be Typed

APPLICATION FOR SURFACE PIT

Submit in Duplicate

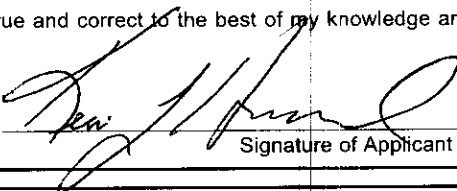Operator Name: Eternity Exploration, Inc		License Number: 34117
Operator Address: 901 Lavaca Trail, Colleyville, TX 76034		
Contact Person: Carlo Ugolini		Phone Number: (316) 371-5351
Lease Name & Well No.: Werth #1		Pit Location (QQQQ): SE NW SE NW
Type of Pit: <input type="checkbox"/> Emergency Pit <input type="checkbox"/> Burn Pit <input type="checkbox"/> Settling Pit <input checked="" type="checkbox"/> Drilling Pit <input type="checkbox"/> Workover Pit <input type="checkbox"/> Haul-Off Pit <i>(If WP Supply API No. or Year Drilled)</i>		Pit is: <input checked="" type="checkbox"/> Proposed <input type="checkbox"/> Existing If Existing, date constructed: _____ Pit capacity: 300 (bbls)
Is the pit located in a Sensitive Ground Water Area? <input type="checkbox"/> Yes <input checked="" type="checkbox"/> No		Sec. 2 Twp. 10 R. 26 <input type="checkbox"/> East <input checked="" type="checkbox"/> West 3,430 Feet from <input checked="" type="checkbox"/> North / <input checked="" type="checkbox"/> South Line of Section 1,584 Feet from <input checked="" type="checkbox"/> East / <input checked="" type="checkbox"/> West Line of Section Sheridan County
Chloride concentration: _____ mg/l <i>(For Emergency Pits and Settling Pits only)</i>		How is the pit lined if a plastic liner is not used? With Bentonite Drilling Mud
Is the bottom below ground level? <input checked="" type="checkbox"/> Yes <input type="checkbox"/> No		Artificial Liner? <input type="checkbox"/> Yes <input checked="" type="checkbox"/> No
Pit dimensions (all but working pits): <u>70</u> Length (feet) <u>70</u> Width (feet) <input type="checkbox"/> N/A: Steel Pits Depth from ground level to deepest point: <u>4</u> (feet) <input type="checkbox"/> No Pit		
If the pit is lined give a brief description of the liner material, thickness and installation procedure. The pit will be constructed and dry bentonite will be placed on the surface of the pit and compacted with a dozer		Describe procedures for periodic maintenance and determining liner integrity, including any special monitoring. Will monitor fluid level in pits twice daily.
Distance to nearest water well within one-mile of pit <u>1,500</u> feet Depth of water well <u>100</u> feet		Depth to shallowest fresh water <u>70</u> feet. Source of information: <input type="checkbox"/> measured <input checked="" type="checkbox"/> well owner <input type="checkbox"/> electric log <input type="checkbox"/> KDWR
Emergency, Settling and Burn Pits ONLY: Producing Formation: <u>NA</u> Number of producing wells on lease: <u>0</u> Barrels of fluid produced daily: <u>0</u> Does the slope from the tank battery allow all spilled fluids to flow into the pit? <input type="checkbox"/> Yes <input checked="" type="checkbox"/> No		Drilling, Workover and Haul-Off Pits ONLY: Type of material utilized in drilling/workover: <u>Chemical Mud</u> Number of working pits to be utilized: <u>3</u> Abandonment procedure: <u>remove fluids, allow to dry then backfill within 365 days.</u> Drill pits must be closed within 365 days of spud date.
RECEIVED KANSAS CORPORATION COMMISSION		
I hereby certify that the above statements are true and correct to the best of my knowledge and belief.		APR 28 2008 CONSERVATION DIVISION WICHITA, KS
Date: <u>4/25/08</u>		Signature of Applicant or Agent: 

15-179-21197-0000

KCC OFFICE USE ONLY

Steel Pit RFAC RFAS

Date Received: 4/28/08 Permit Number: _____ Permit Date: 4/28/08 Lease Inspection: Yes No