

STATE OF KANSAS  
STATE CORPORATION COMMISSION

WELL PLUGGING RECORD

Give All Information Completely  
Make Required Affidavit  
Mail or Deliver Report to  
Conservation Division  
State Corporation Comm.  
245 North Water  
Wichita, KS 67202

Butler County, Sec. 30 Twp. 27 Rge. 3 E/W  
Location as "NE/CNW $\frac{1}{4}$ /SW $\frac{1}{4}$ " or footage from lines  
NE SW SE


Lease Owner Camio Oil Co.  
Lease Name Baker Well No. #1  
Office Address 2525 N. New York Bldg. 2 Office 201 Wichita, Ks. 67219  
Character of Well (Completed as Oil, Gas or Dry Hole)  
Dry Hole.

Date Well completed 7-24 1981  
Application for plugging filed 7-24 1981  
Application for plugging approved 7-24 1981  
Plugging commenced 7-24 1981  
Plugging completed 7-24 1981  
Reason for abandonment of well or producing formation

If a producing well is abandoned, date of last production 19

Was permission obtained from the Conservation Division or its agents before plugging was commenced? Yes

Name of Conservation Agent who supervised plugging of this well Don Thompson  
Producing formation Depth to top Bottom Total Depth of Well 3185  
Show depth and thickness of all water, oil and gas formations.

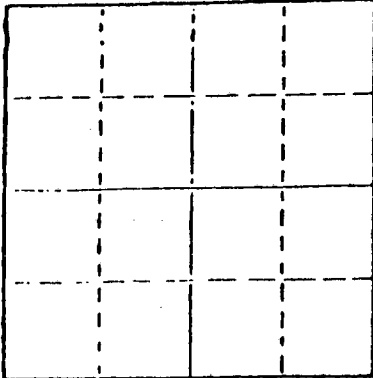

Locate well correctly on above Section Plot

OIL, GAS OR WATER RECORDS

CASING RECORD

FORMATION	CONTENT	FROM	TO	SIZE	PUT IN	PULLED OUT
				8 5/8	216'	NONE

Describe in detail the manner in which the well was plugged, indicating where the mud fluid was placed and the method or methods used in introducing it into the hold. If cement or other plugs were used, state the character of same and depth placed, from feet to feet for each plug set.


Mud to 225', 1/2 sk. hulls, plug, 30 sx. cement.  
Mud to 50', 1/2 sk. hulls, plug, 15 sx. cement.  
5 sx. cement in rathole.

RECEIVED  
STATE CORPORATION COMMISSION  
8/10/81  
AUG 10 1981

(If additional description is necessary, use BACK of this sheet)  
Name of Plugging Contractor White & Ellis Drilling, Inc.  
401 E. Douglas Suite 500 Wichita, Ks. 67202

STATE OF Kansas COUNTY OF Sedgwick  
Ernest Sifford (employee of owner) or (owner or operator)

of the above-described well, being first duly sworn on oath, says: That I have knowledge of the facts, statements, and matters herein contained and the log of the above-described well as filed and that the same are true and correct. So help me God.

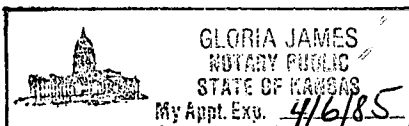

(Signature) Ernest Sifford  
401 E. Douglas #500 Wichita, Ks. 67202  
(Address)

SUBSCRIBED AND SWORN TO before me this 7th day of August, 1981

My commission expires April 6, 1985  
Gloria James Notary Public.

15-015-21796-00-00

DRILLERS LOG

OPERATOR: Camio Oil Co. 2525 N. New York Bldg. 2 Office 201 Wichita, Ks.  
CONTRACTOR: White & Ellis Drilling, Inc., Box 448, El Dorado, Kansas 67042 67219

Lease Name Baker Well No. #1

Sec. 30 T. 27 R. 3E Spot NE SW SE

County Butler State Kansas Elevation \_\_\_\_\_

Casing Record:

Surface: 8 5/8 @ 216' with \_\_\_\_\_ Sxs.

Production: \_\_\_\_\_ @ \_\_\_\_\_ with \_\_\_\_\_ Sxs.

Type Well: D & A Total Depth 3185'

Drilling Commenced: 7-18-81 Drilling Completed 7-25-81

Formation	From	To	Tops
Cellar	0	7	Lansing 2014
Shale, Lime	7	1400	Kansas City 2193
Lime, Shale	1400	1550	Marmaton 2619
Sand, Shale, Lime	1550	1583	Mississippi 2838
Lime, Shale	1583	1604	Simpson 3118
Lime, Shale, Sand	1604	1820	
Sand, Shale	1820	2014	
Lime	2014	2070	
Shale, Lime	2070	2193	
Lime	2193	2245	
Shale, Lime	2245	2358	
Lime	2358	2553	
Lime, Shale	2553	2619	
Lime	2619	3096	
Lime, Shale	3096	3105	
Shale	3105	3118	
Shale, Sand	3118	3185	

RECEIVED  
STATE CORPORATION COMMISSION  
AUG 10 1981  
CONSERVATION DIVISION  
Wichita Kansas

COMPLETION RECORD

Liner Record: Size \_\_\_\_\_ From \_\_\_\_\_ To \_\_\_\_\_

Cementing Record: \_\_\_\_\_ Sacks \_\_\_\_\_

Perforating Record:

Formation	Perforated Interval	Number Shots

Initial Production: \_\_\_\_\_

Electric Log \_\_\_\_\_ Type and Depths Covered \_\_\_\_\_