

15-015-19798-00-00

WELL PLUGGING RECORD


STATE OF KANSAS STATE CORPORATION COMMISSION

FORMATION PLUGGING RECORD

Strike out upper line when reporting plugging off formations.

Give All Information Completely Make Required Affidavit Mail or Deliver Report to: Conservation Division State Corporation Commission 800 Bitting Building Wichita, Kansas

Butler County, Sec. 30 Twp. 27S Rge. 3E (E) (W)

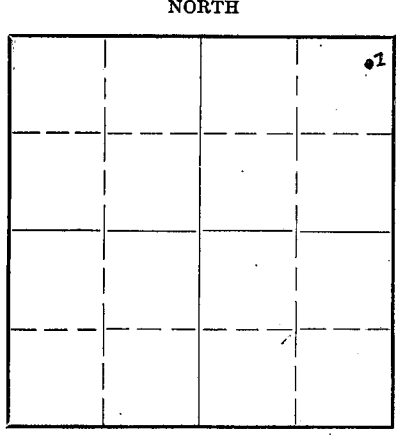

Location as "NE 1/4 NW 1/4 SW 1/4" or footage from lines NE NE NE
Lease Owner The Texas Company
Lease Name A. D. Bales Well No. 1
Office Address 614 Bitting Bldg., Wichita, Kansas
Character of Well (completed as Oil, Gas or Dry Hole) Dry Hole
Date well completed September 1, 19 44
Application for plugging filed August 31, 19 44
Application for plugging approved August 31, 19 44
Plugging commenced September 1, 19 44
Plugging completed September 1, 19 44
Reason for abandonment of well or producing formation Dry Hole

Locate well correctly on above Section Plat

Name of Conservation Agent who supervised plugging of this well A. L. Loman
Producing formation Depth to top Bottom Total Depth of Well 3280' Feet
Show depth and thickness of all water, oil and gas formations.

OIL, GAS OR WATER RECORDS


CASING RECORD

Table with 7 columns: Formation, Content, From, To, Size, Put In, Pulled Out. Row 1: 10-3/4", 105', none

Describe in detail the manner in which the well was plugged, indicating where the mud fluid was placed and the method or methods used in introducing it into the hold. If cement or other plugs were used, state the character of same and depth placed, from feet to feet for each plug set.

Heavy mud from 3280' to 150' w/ wood plug set at 150'
15 sacks bulk cement from 150' to 125'
Heavy mud from 125' to 15'
Cement from 15' to surface

PLUGGING
FILED 30-27R-3E
BOOK PAGE 29 LINE 13

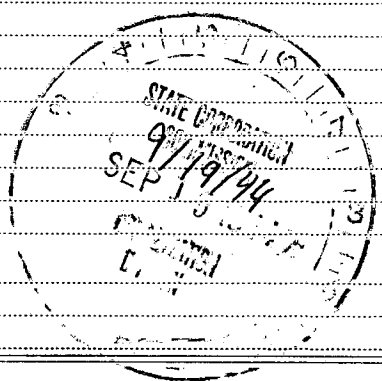

(If additional description is necessary, use BACK of this sheet)

Correspondence regarding this well should be addressed to The Texas Company
Address 614 Bitting Bldg., Wichita, Kansas

STATE OF Kansas COUNTY OF Sedgwick, ss.

M. C. Harrell (employee of owner) or SWYDOK KEDENOK of the above-described well, being first duly sworn on oath, says: That I have knowledge of the facts, statements, and matters herein contained and the log of the above-described well as filed and that the same are true and correct. So help me God.

(Signature) M. C. Harrell
614 Bitting Bldg., Wichita, Kansas (Address)



SUBSCRIBED AND SWORN to before me this 19th day of September, 19 44
Bertha W. Butts Notary Public.

My commission expires 8/26/45

LOG OF WELL

SHEET 1

OWNER The Texas Company DIVISION Oklahoma DATE MADE Sept 7, 1944
 DISTRICT Kansas LEASE A. D. Bales WELL NO. 1
 STATE Kansas COUNTY OR PARISH Butler TWP. 27S RANGE 3E SEC. 30
 LOCATION OF WELL NE NE NE

COMMENCED RIGGING UP 8/11/44 COMMENCED DRILLING 8/14/44 COMPLETED DRILLING 9/1/44
 DAY DRILLER _____ NIGHT DRILLER _____ CONTRACTOR E. B. Uhwyer
 CABLE FROM _____ TO _____ ROTARY FROM 0 TO 3280' COMPANY RIG No. _____
 TOTAL DEPTH 3280' MEASURED BY H. C. Carroll ELEVATION 1322'

CASING RECORD

SIZE	WEIGHT	PUT IN WELL		PULLED OUT		LOST IN WELL		SHOES		PACKERS			
		FEET	INS.	FEET	INS.	FEET	INS.	LENGTH	MAKE	KIND	LENGTH	SET AT	
<u>10-3/4"</u>	<u>32.750</u>	<u>105'</u>		<u>Cemented with 65' max case ad</u>									<u>FT.</u>
													<u>FT.</u>
													<u>FT.</u>
WAS CASING CEMENTED? _____ IF SO, HOW MANY SACKS OF CEMENT USED? _____
 LINER: STATE SIZE AND WEIGHT _____ WHERE SET _____ FT. AND INS. BLANK _____ FT. AND INS. PERFORATED _____
 HOW PUT TOGETHER _____ COUPLING _____ FLUSH-JOINT _____ INSERTED _____
 REMARKS: _____

EQUIPMENT RECORD

TUBING				SUCKER RODS			PUMPING OUTFIT
SIZE	WEIGHT	FEET	INS.	FEET	INS.	SIZE AND KIND	DESCRIPTION, KIND, SIZE, ETC.

FLOWING, PUMPING, GASSER OR DRY DRY PRODUCTION FIRST 24 HOURS _____ PRODUCTION SETTLED _____
 IF GAS WELL, OPEN FLOW CAPACITY _____ SHUT IN PRESSURE _____ ROCK PRESSURE _____
 KIND OF SHOT _____ SIZE OF SHOT, QUARTS _____
 NUMBER OF SHELLS _____ SIZE OF SHELLS _____ INCHES, DIAMETER _____
 LENGTH OF SHELLS _____ FEET _____ INCHES _____ TOP OF SHOT _____
 BOTTOM OF SHOT _____ ANCHOR _____ WELL BRIDGED TO _____
 TOTAL DEPTH OF WELL _____ NUMBER OF SHOT _____ PRODUCTION BEFORE SHOT _____ BBLs. PER DAY _____
 PRODUCTION AFTER SHOT _____ BBLs. PER DAY. SHOT FURNISHED BY _____
 NAME OF SHOOTER _____ SHOT INSPECTED _____ BY _____ (COMPANY EMPLOYEE) _____
 COMMENCED DRILLING DEEPER _____ COMPLETED _____ DRILLING DEEPER _____

REMARKS: Dry & Abandoned

PLUGGING
 FILE SEC 30, 27R-3E
 BOOK PAGE 129, LINE 13

NOTE: IF WELL WAS DRY, STATE UNDER REMARKS, WHEN, HOW, AND BY WHOM PLUGGED.
 STATE UNDER REMARKS ANYTHING OF INTEREST NOT COVERED IN LOG.
 IF THE SPACE PROVIDED FOR REMARKS IS NOT SUFFICIENT WRITE ON BOTTOM OF LAST SHEET OF LOG.

15-015-19798-00-00

LOG OF WELL

SHEET No. 2


District **Kansas**

Owner **The Texas Co.**

Farm **A. D. Bales**

Well No. **1**

FORMATION	AMOUNT	COLOR	HARD OR SOFT	DEPTH CORES TAKEN	REMARKS
Shale	59				
Broken Lime	80				
Lime	119				
Shale & Shells	165				
Lime	180				
Shale & Shells	310				
Lime	380				
Sandy Shale	435				
Lime	470				
Red Rock	475				
Lime	545				
Shale & Shells	1300				
Lime	1392				
Shale & Shells	1430				
Lime	1560				
Shale	1640				
Lime	1670				
Lime, Broken	1688				
Lime	1880				
Shale	2050				
Lime	2110				
Shale	2380				
Lime	2400				
Shale	2415				
K. O. Lime	2610				
Shale	2870				
Chat	2914				
Lime	3105				
Shale	3164				
Sand	3184				
Shale	3228				
Lime	3280	F.D.			

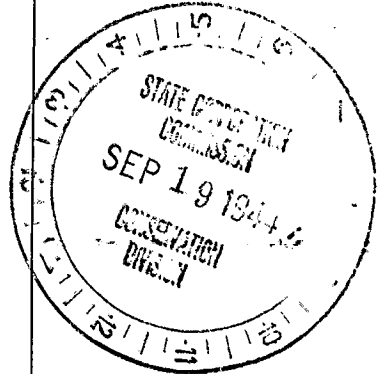

PLUGGING
FILE REC. 30127R.3E
BOOK PAGE 29 LINE 13