

15-015-19795-00-00


Form CP-4

STATE OF KANSAS
STATE CORPORATION COMMISSION

Give All Information Completely
Make Required Affidavit
Mail or Deliver Report to:
Conservation Division
State Corporation Commission
211 N. Broadway
Wichita, Kansas

WELL PLUGGING RECORD

NORTH

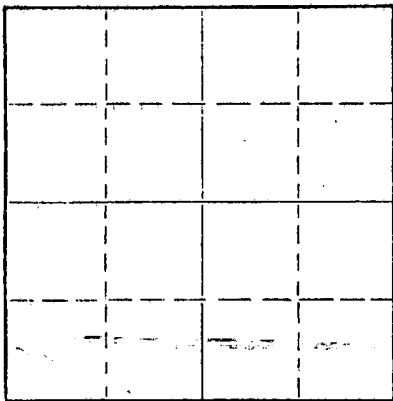

Locate well correctly on above
Section Plot

Butler County, Sec. 28 Twp. 27 Rge. 3E (E) (W)
Location as "NE/CNW/SW" or footage from lines. NE NE NW
Lease Owner Shawver-Armour, Inc.
Lease Name McEwen Well No. 1-A
Office Address 817 Central Bldg., Wichita, Kans.
Character of Well (completed as Oil, Gas or Dry Hole) D&A
Date well completed 12/29/62 19
Application for plugging filed 12/29/62 19
Application for plugging approved 1/2/63 19
Plugging commenced 12/31/62 19
Plugging completed 12/31/62 19
Reason for abandonment of well or producing formation

If a producing well is abandoned, date of last production 19
Was permission obtained from the Conservation Division or its agents before plugging was commenced? Yes

Name of Conservation Agent who supervised plugging of this well Paul Turpin
Producing formation Depth to top Bottom Total Depth of Well 3044' Feet
Show depth and thickness of all water, oil and gas formations.

OIL, GAS OR WATER RECORDS

CASING RECORD

FORMATION	CONTENT	FROM	TO	SIZE	PUT IN	PULLED OUT

Describe in detail the manner in which the well was plugged, indicating where the mud fluid was placed and the method or methods used in introducing it into the hole. If cement or other plugs were used, state the character of same and depth placed, from feet to feet for each plug set.

Dumped 15 feet of Sand - and added 5 sacks cement in Bottom of Oil String. Mudded to 200 feet. Set a Rock Bridge and added 20 sacks cement. Mud to 30 feet and added 8 sacks cement. Set 5 feet Bridge in rat hole and dumped 2 sacks cement in same.

RECEIVED
STATE CORPORATION COMMISSION
4/9/63
APR 9 1963

CONSERVATION DIVISION
Wichita, Kansas

(If additional description is necessary, use BACK of this sheet)

Name of Plugging Contractor Ralph Comstock Pipe Pulling Co., Inc.,
Address Stafford, Kansas.

STATE OF Kansas, COUNTY OF Sedgewick, ss.
(employee of owner) or (owner or operator) of the above-described well, being first duly sworn on oath, says: That I have knowledge of the facts, statements, and matters herein contained and the log of the above-described well as filed and that the same are true and correct. So help me God.

(Signature) James M. Armour
817 Central Bldg.
(Address)

Subscribed and sworn to before me this 2 day of April, 1963

Marvin Hall
Notary Public.



R

DRILLER'S LOG

FARM NAME: McEwen #1-A

LOCATION: NE NE NW Sec 28-27S-3E
Butler County, Kansas

CONTRACTOR: SHAWVER ARMOUR, INC.

OWNER: SHAWVER ARMOUR, INC. ELEVATION 1301 KB

COMMENCED: November 11, 1962

COMPLETED: November 20, 1962

CASING RECORD: 194' 8 5/8" w/175 sacks cement & 4 sacks cc

FORMATION:

Lime & Shale	740
Shale & Lime	960
Lime & Shale	1045
Shale & Lime	1525
Lime & Shale	1895
Shale & Lime	2327
Lime	2498
Shale & Lime	2599
Lime & Shale	2713
Mississippian	2764
Lime	3040
Simpson	3044
Rotary Total Depth	3044
5 1/2"	3039

TOPS:

Lansing	1916
Kansas City	2303
Mississippina	2762
Kinderhook	2982
Simpson	3038

RECEIVED
STATE CORPORATION COMMISSION

JAN 2 1963

CONSERVATION DIVISION
Wichita, Kansas

STATE OF KANSAS }
SEDGWICK COUNTY } ss

I, James M. Armour, do hereby certify that the above log is a true and correct copy of the above captioned well as shown on the daily drilling reports.

SHAWVER ARMOUR, INC.

BY James M. Armour
James M. Armour

Subscribed and sworn to before me this
12th day of December, 1962.

My commission expires December 29, 1963

Marjorie Hall
Marjorie Hall, Notary Public