

15-015-00301-00-00

STATE OF KANSAS
STATE CORPORATION COMMISSION

WELL PLUGGING RECORD

Give All Information Completely
Make Required Affidavit
Mail or Deliver Report to:
Conservation Division
State Corporation Commission
211 No. Broadway
Wichita, Kansas

Butler County, Sec. 35 Twp. 27 Rge. 3 (E) ~~XW~~

Location as "NE/CNW/SW" or footage from lines SW SW SE

Lease Owner T.L. Ferrier

Lease Name Sparks Well No. 1

Office Address 300 Schweiter Bldg. Wichita, Kansas

Character of Well (completed as Oil, Gas or Dry Hole) dry hole

Date well completed December 8 19 57

Application for plugging filed December 8 19 57

Application for plugging approved December 8 19 57


Plugging commenced December 8 19 57

Plugging completed December 8 19 57

Reason for abandonment of well or producing formation dry hole

If a producing well is abandoned, date of last production 19

Was permission obtained from the Conservation Division or its agents before plugging was commenced? yes

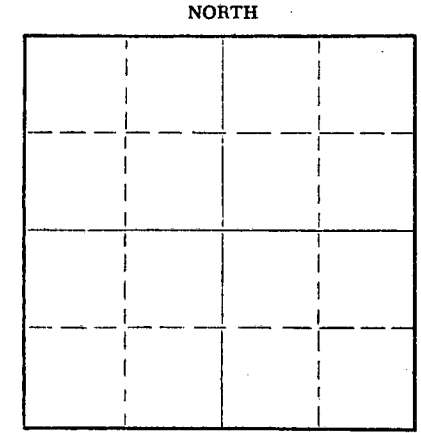

Name of Conservation Agent who supervised plugging of this well Eugene Graham

Producing formation _____ Depth to top _____ Bottom _____ Total Depth of Well 3060 Feet

Show depth and thickness of all water, oil and gas formations.

OIL, GAS OR WATER RECORDS

CASING RECORD

FORMATION	CONTENT	FROM	TO	SIZE	PUT IN	PULLED OUT
				8 5/8	207	none

Describe in detail the manner in which the well was plugged, indicating where the mud fluid was placed and the method or methods used in introducing it into the hole. If cement or other plugs were used, state the character of same and depth placed, from _____ feet to _____ feet for each plug set.

Hole filled with heavy rotary mud to 200 ft. Wooden plug at 200 ft. with 1/2 sack hulls and 15 sacks cement on plug. Hole filled with heavy rotary mud to 40 ft. Wooden plug at 40 ft. with 10 sacks cement on plug.

RECEIVED
STATE CORPORATION COMMISSION
1/3/58
JAN 3 1958

CONSERVATION DIVISION
Wichita, Kansas

Name of Plugging Contractor White & Ellis Drilling, Inc. - License # 209
Address Box 448 El Dorado, Kansas

STATE OF Kansas, COUNTY OF Butler, ss.
Dale R. Daniel, Employee of Contractor (employee of owner) (operator) of the above-described well, being first duly sworn on oath, says: That I have knowledge of the facts, statements, and matters herein contained and the log of the above-described well as filed and that the same are true and correct. So help me God.

(Signature) Dale R. Daniel
Box 448 El Dorado, Kansas
(Address)

SUBSCRIBED AND SWORN TO before me this 13 th day of December, 19 57

Ernest Sifford
Notary Public.



PLUGGING
FILE SEC 35 T 27 R 36
BOOK PAGE 68 LINE 25

Casing Record

Location:

SW SW SE
Sec. 35-27-3E
Butler County, Kansas
Sparks #1
T. L. Ferrier
White & Ellis Drilling, Inc.,
11/30/57
12/8/57

8 5/8 207' Cemented w/175 sacks
T. D. 3060'

Farms:
Well Owner:
Contractor:
Started:
Completed:

Shale	0-100
Shale & limes strks.	145
Lime	207
Lime & shale strks.	370
Lime & shale	750
Shale & Lime strks.	1020
Shale & sand	1050
Shale & shell	1150
Lime & shale	1340
Shale & Lime	1400
Lime & shale strks.	1515
Lime	1580
Shale & lime strks.	1620
Lime & shale	1680
Shale & shell	1860
Lime w/shale	1896

Top of Lansing

Lime	2029
Shale & lime	2195
Shale & lime	2246

Top of Kansas City

Lime	2408
Shale & lime strks.	2489
Shale & lime	2590
Lime & shale strks.	2630
Lime	2668 1/2
Lime & shale	2735

Top of Mississippi

Lime	2888
Shale & lime	2945
Shale & lime strks.	2977

Top of Simpson

Sand	3024
------	------

Top of Arbuckle

Lime	3060
------	------

Dry Hole Plug & Abandon

RECEIVED

1957 DEC 10 10 30 AM

W. L. FERRIER
Butler County, Kansas

PLUGGING	
FILE SEC	35 T 27R 3E
BOOK PAGE	68 LINE 25