


WELL PLUGGING RECORD

Give All Information Completely
Make Required Affidavit
Mail or Deliver Report to:
Conservation Division
State Corporation Commission
800 Bitting Building
Wichita, Kansas

NORTH

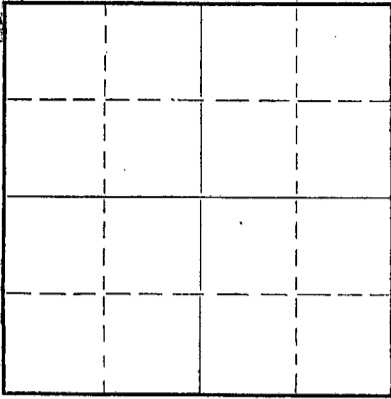

Locate well correctly on above
Section Plat

Butler County. Sec. 36 Twp. 27 Rge. 3 (E) XXXXX
Location as "NE/CNW 1/4 SW 1/4" or footage from lines NW SE NW
Lease Owner Dunne & Strait Drilling Company
Lease Name Markley Well No. 1
Office Address 300 Schweiter Building, Wichita, Kansas
Character of Well (completed as Oil, Gas or Dry Hole) Dry Hole
Date well completed July 30 19 49
Application for plugging filed 19
Application for plugging approved August 4 19 49
Plugging commenced July 30 19 49
Plugging completed July 30 19 49
Reason for abandonment of well or producing formation Dry Hole

If a producing well is abandoned, date of last production 19
Was permission obtained from the Conservation Division or its agents before plugging was commenced? Yes

Name of Conservation Agent who supervised plugging of this well A. L. Loman, 414 W. Locust, El Dorado, Kansas
Producing formation Depth to top Bottom Total Depth of Well 3005 Feet
Show depth and thickness of all water, oil and gas formations.

OIL, GAS OR WATER RECORDS

CASING RECORD

Formation	Content	From	To	Size	Put In	Pulled Out

Describe in detail the manner in which the well was plugged, indicating where the mud fluid was placed and the method or methods used in introducing it into the hole. If cement or other plugs were used, state the character of same and depth placed, from feet to feet for each plug set.
Mud to 135'
10 Sacks cement on wood plug at 135'
Mud to Surface
3 Sacks cement cap

RECORDED
8/8/49
AUG 8 - 1949
STATE CORPORATION
COMMISSION
KANSAS

(If additional description is necessary, use BACK of this sheet)
Correspondence regarding this well should be addressed to Dunne & Strait Drilling Company
Address 300 Schweiter Building, Wichita, Kansas

STATE OF Kansas, COUNTY OF Sedgwick, ss.
D. E. Dunne, Jr. (owner or operator) of the above-described well,

being first duly sworn on oath, says: That I have knowledge of the facts, statements, and matters herein contained and the log of the above-described well as filed and that the same are true and correct. So help me God. Dunne & Strait Drilling Company
(Signature) Partner
300 Schweiter Bldg., Wichita, Kansas
(Address)

SUBSCRIBED AND SWORN TO before me this 6th day of August 19 49
Almeda G. Farnack
Notary Public.

My commission expires May 25, 1952

PLUGGING
FILE SEC 36 T 27 R 3E
BOOK PAGE 108 LINE 15

DUNNE & STRAIT DRILLING COMPANY

DRILLING LOG

Lease: Markley #1
 Lease Owner: Dunne & Strait Drilling Co.

County: Butler
 Location: NW 08 NW
 Section: 36-27S-3E

Total Depth: 3005'
 Commenced: 7-17-49
 Completed: 7-30-49
 Casing: Surface Pipe 8 5/8"

0 - 107	Surface
107 - 168	Sand & Lime
168 - 238	Lime
238 - 385	Lime
385 - 392	Red Rock
392 - 695	Lime & Shale
695 - 927	Shale & Shells
927 - 1173	Shale & Lime Shells
1173 - 1986	Lime & Shale
1986 - 2225	Lime
2225 - 2255	Shale
2255 - 2293	K. C. Lime
2293 - 2550	Lime
2550 - 2761	Lime & Shale
2761 - 2812	Lime & Chert
2812 - 2910	Lime
2910 - 2987	Shale
2987 - 3005	Sand Dry Hole

