

15-173-02083-00-00

WELL PLUGGING RECORD

OR FORMATION PLUGGING RECORD

Strike out upper line when reporting plugging off formations.

STATE OF KANSAS
STATE CORPORATION COMMISSION

Give All Information Completely
Make Required Affidavit
Mail or Deliver Report to:
Conservation Division
State Corporation Commission
800 Bitting Building
Wichita, Kansas

Sedgwick County, Sec. 21 Twp. 27 Rge. 2E (E) (W)

Location as "NE $\frac{1}{4}$ NW $\frac{1}{4}$ SW $\frac{1}{4}$ " or footage from lines SE SE NW

Lease Owner Beech Aircraft Corporation

Lease Name Beech Well No. 1

Office Address Wichita, Kansas

Character of Well (completed as Oil, Gas or Dry Hole) Dry Hole

Date well completed September 29, 1943

Application for plugging filed October 9, 1943

Application for plugging approved 19

Plugging commenced September 29, 1943

Plugging completed September 29, 1943


Reason for abandonment of well or producing formation

Dry Hole

If a producing well is abandoned, date of last production 19

Was permission obtained from the Conservation Division or its agents before plugging was commenced? Yes

NORTH

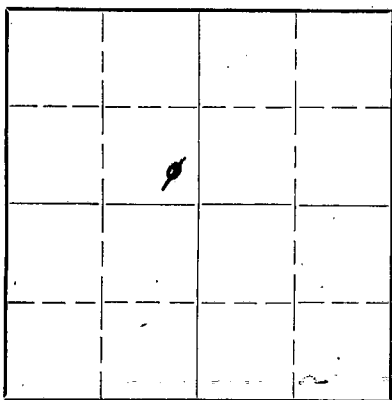

Locate well correctly on above Section Plat

Name of Conservation Agent who supervised plugging of this well

Producing formation Depth to top Bottom Total Depth of Well 3400 Feet

Show depth and thickness of all water, oil and gas formations.

OIL, GAS OR WATER RECORDS


CASING RECORD

Formation	Content	From	To	Size	Put In	Pulled Out

Describe in detail the manner in which the well was plugged, indicating where the mud fluid was placed and the method or methods used in introducing it into the hold. If cement or other plugs were used, state the character of same and depth placed, from feet to feet for each plug set.

Hole was filled with heavy mud from total depth to 114 feet of the surface and cemented with 20 sax of cement and mudded to 26 feet of the surface and cemented with 20 sax of cement to top of the surface pipe

21 27 2E
92 40

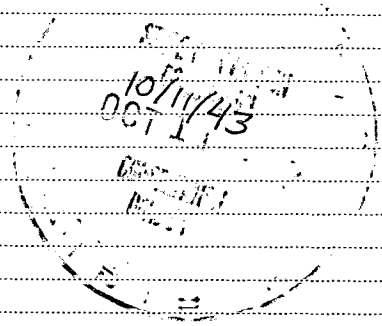

(If additional description is necessary, use BACK of this sheet)

Correspondence regarding this well should be addressed to Falcon Seaboard Drilling Company

Address 107 Philtower Building, Tulsa 3, Oklahoma

STATE OF Oklahoma COUNTY OF Tulsa, ss.

S. H. Johnson (employee of owner) or (owner or operator) of the above-described well,

being first duly sworn on oath, says: That I have knowledge of the facts, statements, and matters herein contained and the log of the above-described well as filed and that the same are true and correct. So help me God.

(Signature) S. H. Johnson

107 Philtower Building, Tulsa 3, Oklahoma

(Address)

SUBSCRIBED AND SWORN to before me this 9th day of October, 19 43

Dalores Walsh

Notary Public.



DRILLER'S LOG
 BEECH AIRPORT #1 WELL
 SE SE NW SECTION 21-27S-2E
 SEDGWICK COUNTY, KANSAS

Shale and Lime	0 feet to	130 feet	114' - 10-3/4" O.D. Casing
Lime	130	138	Cemented w/100 sacks incore
Anhydrite	138	195	Bulk Cement
Broken Lime	195	275	
Shale and Lime	275	965	
Shale and Shells	965	1540	
Lime and Shale	1540	1855	
Lime	1855	1985	
Shale and Lime	1985	2315	
Shale	2315	2339	
Broken Lime	2339	2425	
Shale	2425	2478	
Shale and Lime	2478	2521	
Lime	2521	2626	
Broken Lime	2626	2661	
Shale	2661	2700	
Shale and Lime	2700	2975	
Lime (Chat)	2975	3068	
Lime and Shale	3068	3087	
Lime	3087	3117	
Shale and Lime	3117	3316	
Sand and Shale	3316	3375	
Lime and Shale	3375	3400	

I hereby certify that the above and foregoing log is a true and correct copy of the driller's log on the Beech Airport #1 Well, located in the SE/4 SE/4 NW/4 of Section 21-27S-2E, Sedgwick County, Kansas.

FALCON SEABOARD DRILLING COMPANY

S. H. Johnson
 Secretary

Subscribed and sworn to before me, a Notary Public, this 5th day of October, 1943.

My Commission Expires
 February 5, 1946.

Valere Walsh
 Notary Public

21 27 2E
 92 40