


15-173-00656-00-00

STATE OF KANSAS  
STATE CORPORATION COMMISSION

Give All Information Completely .  
Make Required Affidavit  
Mail or Deliver Report to:  
Conservation Division  
State Corporation Commission  
800 Bittling Building  
Wichita, Kansas

WELL PLUGGING RECORD

NORTH

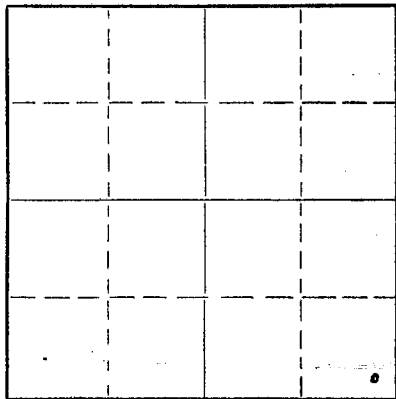

Locate well correctly on above  
Section Plat

Sedgwick County. Sec. 21 Twp. 27S Rge. 2 (E) (W)  
Location as "NE/CNW/SW" or footage from lines 330' from East & South Lines.  
Lease Owner Bankoff Oil Co.  
Lease Name Jackson (Dillon) <sup>KCC</sup> ~~340~~ Well No. 1  
Office Address P. O. BOX 2301, TULSA, 1, OKLAHOMA.  
Character of Well (completed as Oil, Gas or Dry Hole) Dry Hole  
Date well completed 12-19-52 19  
Application for plugging filed 2-19-53 19  
Application for plugging approved 19  
Plugging commenced 12-19-52 19  
Plugging completed 12-19-52 19  
Reason for abandonment of well or producing formation Dry Hole

If a producing well is abandoned, date of last production 19  
Was permission obtained from the Conservation Division or its agents before plugging was commenced? Yes

Name of Conservation Agent who supervised plugging of this well Mr. S. S. Greider  
Producing formation dry Depth to top Bottom Total Depth of Well 3362 Feet  
Show depth and thickness of all water, oil and gas formations.

OIL, GAS OR WATER RECORDS

CASING RECORD

FORMATION	CONTENT	FROM	TO	SIZE	PUT IN	PULLED OUT
				12 1/4"	128'	None
				(Surface Casing left in hole.)		

Describe in detail the manner in which the well was plugged, indicating where the mud fluid was placed and the method or methods used in introducing it into the hole. If cement or other plugs were used, state the character of same and depth placed, from feet to feet for each plug set.  
Pumped Mud from 3362 to 128.  
Set Wooden Plug and dumped 15 sacks of Cement at 128.  
Pumped Mud from 128 to 15 feet.  
Set Plug and dumped 10 sacks of cement at 15 feet.

(If additional description is necessary, use BACK of this sheet)

Name of Plugging Contractor Gaines Drilling Company, Inc.  
Address P. O. Box 547, El Dorado, Kansas.

STATE OF Kansas, COUNTY OF Butler, ss.  
Glen Gaines, Drilling Contractor, of the above-described well, being first duly sworn on oath, says: That I have knowledge of the facts, statements, and matters herein contained and the log of the above-described well as filed and that the same are true and correct.. So help me God.

(Signature) Glen Gaines

P. O. Box 547, El Dorado, Kansas.  
(Address)

SUBSCRIBED AND SWORN to before me this 19th day of February, 1953.

Ernest H. Burke

Notary Public.

My commission expires August 20, 1955

24-2675-5

2-52-20W

FILED  
FEB 21 1953  
WICHITA, KANSAS

PLUGGING

FILE SEC 21 T 27 R 2E  
BOOK PAGE 46 LINE 38

15-173-00656-00-00

## KANSAS WELL LOG BUREAU---KANSAS GEOLOGICAL SOCIETY

412 UNION NATIONAL BANK BUILDING - WICHITA, KANSAS

COMPANY Bankoff Oil Company

SEC. 21 T. 27S R. 2E

FARM Jackson (Dillon) NO. 1

LOC. SE SE SE

TOTAL DEPTH 3362

COMM. December 3, 1952


COMP. December 19, 1952

~~SHOT OR TREATED~~

CONTRACTOR Gaines Drilling Company, Inc.

Sedgwick

COUNTY

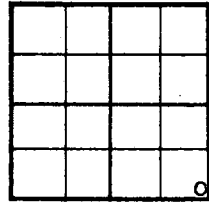

## CASING

20	10	12 $\frac{1}{2}$ " 128' Surface casing left in hole
15 $\frac{1}{2}$	8 $\frac{1}{4}$	
12 $\frac{1}{2}$	6 $\frac{3}{4}$	
13 $\frac{3}{4}$	5 $\frac{1}{2}$	

ELEVATION ✓

PRODUCTION D &amp; A

## FIGURES INDICATE BOTTOM OF FORMATIONS

Soil	5
Clay	15
Shale & Shells	75
Sand	78
Lime	100
Shale & Shells	125
Sand	128
Lime	140
Lime & Shale	600
Shale & Shells	770
Lime & Shale	2060
Shale	2109
Lime	2130
Lime & Shale	2475
Lime	2725
Lime & Shale	2943
Mississippi Lime	3195
Shale	3225
Lime & Shale	3255
Simpson Sand	3287
Lime & Shale	3328
Shale	3333
Lime	3362

**PLUGGING**

FILE SEC 21 T 27 R 2E

BOOK PAGE 46 LINE 38

RECEIVED  
STATE CORPORATION COMMISSION

MAR - 4 1953

CONSERVATION DIVISION  
Wichita, Kansas