

Give All Information Completely
Make Required Affidavit
Mail or Deliver Report to:
Conservation Division
State Corporation Commission
800 Bittling Building
Wichita, Kansas

15-173-00841-00-01
WELL PLUGGING RECORD

OR
FORMATION PLUGGING RECORD

Strike out upper line
when reporting plug-
ging off formations.

NORTH

			#01
			#2

Locate well correctly on above
Section Plat

Name of Conservation Agent who supervised plugging of this well Williams, Raymond
Producing formation 2960 Depth to top 2956 Bottom 2960 Total Depth of Well 2960 Feet
Show depth and thickness of all water, oil and gas formations.


OIL, GAS OR WATER RECORDS

CASING RECORD

Formation	Content	From	To	Size	Put In	Pulled Out
Large pipe pulled at completion						
6 5/8" casing set at 2955						
surface pipe set at 45'						
					45'	

Describe in detail the manner in which the well was plugged, indicating where the mud fluid was placed and the method or methods used in introducing it into the hole. If cement or other plugs were used, state the character of same and depth placed, from _____ feet to _____ feet for each plug set.

total depth of well 2960 6" hole
Cement to 2945 - 3 sack
mud to 55'
Cement to 40' - 2.5 sack
mud to 10'
Cement to surface

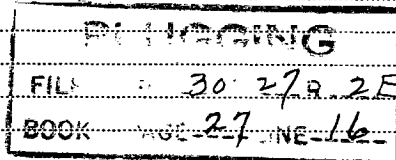

(If additional description is necessary, use BACK of this sheet)

Correspondence regarding this well should be addressed to Edward Schaper
Address Valley Center, Kansas

STATE OF _____ COUNTY OF _____, ss.

_____ (employee of owner) or (owner or operator) of the above-described well,
being first duly sworn on oath, says: That I have knowledge of the facts, statements, and matters herein contained and the log of the above-described well as filed and that the same are true and correct. So help me God.

(Signature) Edward Schaper

(Address) _____

SUBSCRIBED AND SWORN to before me this 27th day of April 1942

My commission expires April 5, 1945
Notary Public.

Received
4/28/42