

15-163-2006-00-00


Form CP-4

STATE OF KANSAS
STATE CORPORATION COMMISSION

Give All Information Completely
Make Required Affidavit
Mail or Deliver Report to:
Conservation Division
State Corporation Commission
212 No. Market
Wichita, Kansas

WELL PLUGGING RECORD

NORTH

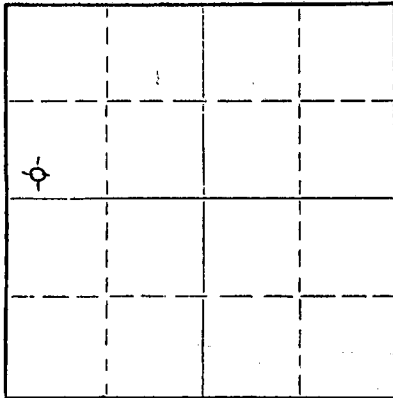

Locate well correctly on above
Section Plat

Rooks County, Sec. 32 Twp. 10S Rge. (E) 16W(W)

Location as "NE/CNW/SW" or footage from lines SW $\frac{1}{4}$ SW $\frac{1}{4}$ NW $\frac{1}{4}$

Lease Owner Birmingham-Bartlett Drilling Co., et al

Lease Name Whisman "A" Well No. 1

Office Address 300 Kaufman Building, Wichita, Kansas, 67202

Character of Well (completed as Oil, Gas or Dry Hole) Dry Hole

Date well completed March 10, 1967

Application for plugging filed (verbally approved) March 14, 1967

Application for plugging approved (" ") March 13, 1967

Plugging commenced March 10, 1967

Plugging completed March 10, 1967

Reason for abandonment of well or producing formation

If a producing well is abandoned, date of last production 19

Was permission obtained from the Conservation Division or its agents before plugging was commenced? Yes

Name of Conservation Agent who supervised plugging of this well Leo F. Massey

Producing formation Depth to top Bottom Total Depth of Well 3570 Feet

Show depth and thickness of all water, oil and gas formations.

OIL, GAS OR WATER RECORDS

CASING RECORD

FORMATION	CONTENT	FROM	TO	SIZE	PUT IN	PULLED OUT
		0	243	8-5/8"	243'	None

Describe in detail the manner in which the well was plugged, indicating where the mud fluid was placed and the method or methods used in introducing it into the hole. If cement or other plugs were used, state the character of same and depth placed, from feet to feet for each plug set.

Bottom plug set at 540' with 20 sacks cement.

Center plug set at 240' with 20 sacks cement.

Top plug set at 40' with 10 sacks cement.

RECEIVED
STATE CORPORATION COMMISSION
03-15-1967
MAR 15 1967

CONSERVATION DIVISION
WICHITA, KANSAS

(If additional description is necessary, use BACK of this sheet)

Name of Plugging Contractor Birmingham-Bartlett Drilling Co.

Address (given above)

STATE OF KANSAS COUNTY OF SEDGWICK, ss.

Richard Hindery, partner of part-owner and operator (employee of owner) or (owner or operator) of the above-described well, being first duly sworn on oath, says: That I have knowledge of the facts, statements, and matters herein contained and the log of the above-described well as filed and that the same are true and correct. So help me God. BIRMINGHAM-BARTLETT DRILLING CO.

(Signature) By Richard Hindery

300 Kaufman Building, Wichita, Kansas, 67202

(Address)

SUBSCRIBED AND SWORN TO before me this 14th day of March, 1967

My commission expires November 29, 1970.

Vivian F. Yinger

Notary Public.








Plugged on 3-10-67.

L.F.A.

(Figures indicate bottom of formation)


RECEIVED
KANSAS COMMISSIONMAR 15 1967
03-15-1967
CONSERVATION DIVISION
KANSAS

The undersigned, Richard Hindery, one of the partners of Birmingham-Cortlett Drilling Co., hereby certifies that the above is a true and correct log of the WELSH "A" NO. 1 LHA as shown in the daily drilling reports.

BIRMINGHAM-CORTELLT DRILLING CO.

By Richard Hindery
Richard Hindery, Partner

Subscribed and sworn to before me
this 10th day of March, 1967.

Walter F. Tinger
Walter F. Tinger, Notary Public

My commission expires November 23, 1970.