

STATE OF KANSAS
STATE CORPORATION COMMISSION


15-163-19371-00-01

WELL PLUGGING RECORD

Give All Information Completely
Make Required Affidavit
Mail or Deliver Report to
Conservation Division
State Corporation Comm.
245 North Water
Wichita, KS 67202

Rooks County, Sec. 2 Twp. 105 Rge. 16 E/W
Location as "NE/CNW $\frac{1}{4}$ /SW $\frac{1}{4}$ " or footage from lines
330 N 330 E of S/4 cor.

Lease Owner Cities Service Company
Lease Name Kruse Unit Well No. 205W
Office Address 209 E. William, Wichita, Kansas 67202
Character of Well (Completed as Oil, Gas or Dry Hole)
OIL

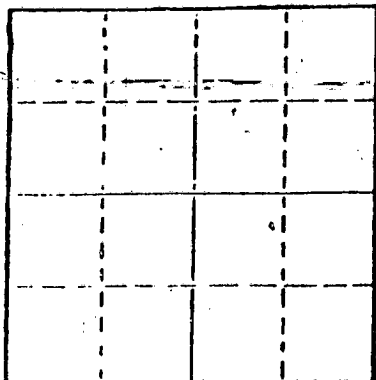

Locate well correctly on above
Section Plat

Date Well completed 12-12 1963
Application for plugging filed 3-07 1978
Application for plugging approved 3-09 1978
Plugging commenced 5-11 1978
Plugging completed 5-11 1978

Reason for abandonment of well or producing formation
Not economically feasible to repair well.
If a producing well is abandoned, date of last production
Water injection well 19

Was permission obtained from the Conservation Division or
its agents before plugging was commenced? YES

Name of Conservation Agent who supervised plugging of this well Leo Massey
Producing formation L-KC Depth to top 3045 Bottom 3129 Total Depth of Well 3856
Show depth and thickness of all water, oil and gas formations.

OIL, GAS OR WATER RECORDS

CASING RECORD

FORMATION	CONTENT	FROM	TO	SIZE	PUT IN	PULLED OUT
				8 5/8"	241 ft.	-0-
				5 1/2"	3436 ft.	-0-

Describe in detail the manner in which the well was plugged, -indicating where the mud fluid
was placed and the method or methods used in introducing it into the hold. If cement or other
plugs were used, state the character of same and depth placed, from _____ feet to
_____ feet for each plug set.

Pushed 5 1/2" rubber plug to 615 ft., with tubing displaced 35 sacks common cement.
Cement from 335 ft. to 615 ft. Pushed 5 1/2" plug to 90 ft. and pumped 15 sacks
cement from 0-90 ft. Completed at 11:00 a.m., 5-11-78

(If additional description is necessary, use BACK of this sheet)

Name of Plugging Contractor Halliburton Oil Well Cementing Co.


STATE OF Kansas COUNTY OF Sedgwick, ss.
Eugene D. Bentley (employee of owner) or (owner or operator)
of the above-described well, being first duly sworn on oath, says: That I have knowledge of
the facts, statements, and matters herein contained and the log of the above-described well
as filed and that the same are true and correct. So help me God.

(Signature) Eugene D. Bentley Eugene D. Bentley
209 E. William, Wichita, Kansas 67202
(Address)

SUBSCRIBED AND SWORN TO before me this 19 day of September, 1978

Dean Caldwell Notary Public.

My commission expires 10-16-81

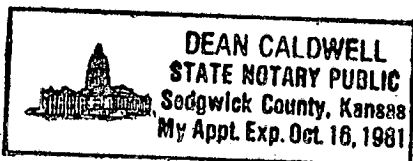

RECEIVED
STATE CORPORATION COMMISSION
9/21/78
SEP 21 1978

CONSERVATION DIVISION
Wichita, Kansas

Cities Service Oil Company

Erway #5 S.W.D.
 330' N. and 330' E. of S/4 Cor.
 Sec. 2-10-16W
 Rooks County, Kansas
 Elevation - 1932 (1930 Gr.)

Casing Record

8-5/8" @ 241' cem. 175 sx cement
 5-1/2" @ 3436' cem. 200 sx cement

Two-stage cementing collar at 1107'
 with 275 sacks cement and 70 sacks
 Stratacrete.

Formation Record

shale & shells	0-242
shale	510
shale, shells & red bed	1030
red bed	1085
anhydrite	1121
shale & shells	1975
lime	2075

Hole 6° off at 2000'.

Plugged back to 1300' with
 360 sx cement and redrilled
 1300-2075 to straighten hole.

lime & shale	2075-2135
shale	2255
shale & lime	2425
lime & shale	3050
lime	3067
lime & shale	3085
lime	3390
lime & conglomerate	3442
3442 RTD = 3440 SLM	
lime & shale	3455
lime	3467
lime & shale	3480
lime	3500
sandy lime	3520
lime	3580
sandy lime	3600
lime	3660
sandy lime	3685
lime	3753
cherty lime	3789
sandy lime	3830
lime	3867

3867 sand line = 3856 SLM