


Give All Information Completely
Make Required Affidavit
Mail or Deliver Report to:
Conservation Division
State Corporation Commission
211 No. Broadway
Wichita, Kansas

WELL PLUGGING RECORD

NORTH

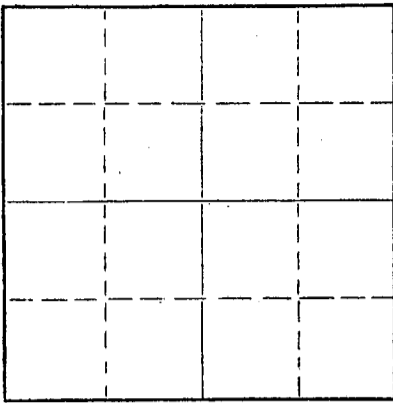

Locate well correctly on above
Section Plat

Butler County. Sec. 5 Twp. 28 Rge. 3E (E) (W)
Location as "NE/CNW%SW%" or footage from lines ~~SW NE NE NW NW SE~~
Lease Owner Wm. L. Graham Oil Company Junior Oil Co. K.C.
Lease Name Graham A KCC Well No. 5
Office Address 1005 East 2nd, Wichita, Kansas
Character of Well (completed as Oil, Gas or Dry Hole) _____
Date well completed _____ 19____
Application for plugging filed _____ 19____
Application for plugging approved _____ 19____
Plugging commenced _____ September 27, 1956
Plugging completed _____ October 4 ~~#####~~ 1956
Reason for abandonment of well or producing formation _____
If a producing well is abandoned, date of last production _____ 19____
Was permission obtained from the Conservation Division or its agents before plugging was commenced? _____ Yes

Name of Conservation Agent who supervised plugging of this well _____
Producing formation _____ Depth to top _____ Bottom _____ Total Depth of Well 3059 Feet
Show depth and thickness of all water, oil and gas formations.

OIL, GAS OR WATER RECORDS

CASING RECORD

FORMATION	CONTENT	FROM	TO	SIZE	PUT IN	PULLED OUT
				5 1/2"		2208.84'

Describe in detail the manner in which the well was plugged, indicating where the mud fluid was placed and the method or methods used in introducing it into the hole. If cement or other plugs were used, state the character of same and depth placed, from _____ feet to _____ feet for each plug set.

T.D. 3059'
Cement (10 Sacks) 3059' 3050'
Mud 3050' 200'
Rock 200' 185'
Cement (15 Sacks) 185' 155'
Left hole open for fresh water well.

(If additional description is necessary, use BACK of this sheet)

Name of Plugging Contractor V. W. McKnab
Address 1117 Millington, Winfield, Kansas

STATE OF Kansas, COUNTY OF Sedgewick, ss.

(employee, of owner) or (owner or operator) of the above-described well, being first duly sworn on oath, says: That I have knowledge of the facts, statements, and matters herein contained and the log of the above-described well as filed and that the same are true and correct. So help me God.

(Signature) [Signature]

SUBSCRIBED AND SWORN TO before me this 17th day of October, 1956

My commission expires June 23, 1958
[Signature] Notary Public.



PLUGGING
FILE SEC. 5 T. 28 R. 3E
BOOK PAGE 100 LINE 27

NO DUNCAN
COMMISSION
10/31/56
OCT 31 1956
CONSERVATION DIVISION
Wichita, Kansas

DRILLER'S LOG
NO. 5 GRAHAM "A"
NW NW SE SEC. 5-28S-3E
BUTLER COUNTY, KANSAS

OPERATOR: Wm. L. Graham

COMMENCED: 5-28-55

CONTRACTOR: Mallonee Drilling Company, Inc.

COMPLETED: 6-6-55

<u>FROM</u>	<u>TO</u>	<u>DESCRIPTION</u>	<u>REMARKS</u>
0 -	59	Surface soil & lime	61.8' (2 JTS) 8 5/8" casing set at 59' with 35 sks. cement & 1 sk. Cal. Chloride
59 -	150	Lime & shale	
150 -	460	Lime	
460 -	930	Shale & lime	
930 -	1575	Shale	
1575 -	2550	Lime & shale	
2550 -	2710	Lime	
2710 -	2816	Lime & shale	
2816 -	3060	Lime	
3060 -	3062	Sand	
	3062	Total Depth of Hole	97 jts. 5 1/2" 14# casing set at 3060 with 50 sks. cement

I certify that to the best of my knowledge and belief the above represents a true and accurate Driller's Log record of the captioned well.

W. Mallonee

STATE OF KANSAS)
COUNTY OF SEDGWICK) ss

Subscribed and sworn to before me this 14 day of June, 1955.

Boonman Karse
Notary Public

My commission expires:

Mar 30, 1957



PLUGGING
FILE SEC. 5 T. 28 R. 3E
BOOK PAGE 160 LINE 27