


STATE OF KANSAS  
STATE CORPORATION COMMISSION  
CONSERVATION DIVISION  
P. O. BOX 17027  
WICHITA, KANSAS 67217

FORM CP-4

WELL PLUGGING RECORD

Butler County, Sec. 6 Twp. 28S Rge. 3E (E) (W)

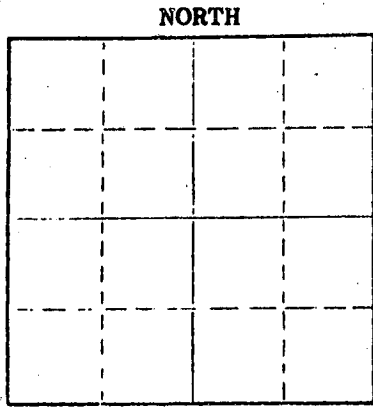

Locate well correctly on above Section Plat

Location as "NE/CNW/SW" or footage from lines C NW NW  
Lease Owner PREMIER PETROLEUM, INC.  
Lease Name Durano Well No. 1  
Office Address 403 Hillside, Wichita, Kansas 67208  
Character of Well (completed as Oil, Gas or Dry Hole) Dry Hole  
Date well completed 9-3 1974  
Application for plugging filed 9-3 1974  
Application for plugging approved 9-3 1974  
Plugging commenced 9-3 1974  
Plugging completed 9-3 1974  
Reason for abandonment of well or producing formation No commercial quantities of oil or gas encountered.  
If a producing well is abandoned, date of last production 19  
Was permission obtained from the Conservation Division or its agents before plugging was commenced? Yes

Name of Conservation Agent who supervised plugging of this well Ted Dewey  
Producing formation \_\_\_\_\_ Depth to top \_\_\_\_\_ Bottom \_\_\_\_\_ Total Depth of Well 3202 Feet  
Show depth and thickness of all water, oil and gas formations.

OIL, GAS OR WATER RECORDS

CASING RECORD

FORMATION	CONTENT	FROM	TO	SIZE	PUT IN	PULLED OUT
Surface Hole	Water	Surface	206	8-5/8"	203	None

Describe in detail the manner in which the well was plugged, indicating where the mud fluid was placed and the method or methods used in introducing it into the hole. If cement or other plugs were used, state the character of same and depth placed, from \_\_\_\_\_ feet to \_\_\_\_\_ feet for each plug set.

Fluid to 225', plug, 20 sx cement;  
Fluid to 40', plug, 10 sx cement;  
Two sacks in rat hole.

RECEIVED  
STATE CORPORATION COMMISSION  
9/12/74  
SEP 12 1974  
CONSERVATION DIVISION  
Wichita, Kansas

Name of Plugging Contractor D N B DRILLING, INC.  
Address 701 First Nat'l Bldg., Wichita, Kansas 67202

STATE OF KANSAS COUNTY OF \_\_\_\_\_  
JAMES L. DONELSON (employee of owner) or (owner or operator) of the above-described

well, being first duly sworn on oath, says: That I have knowledge of the facts, statements, and matters herein contained and the log of the above-described well as filed and that the same are true and correct. So help me God.

(Signature) James L. Donelson  
701 First Nat'l Bldg., Wichita, Ks.  
(Address)

SUBSCRIBED AND SWORN TO before me this 6th day of Sept. 19 74

My commission expires August 25, 1976

Ella Priess  
Notary Public.  
Ella Priess

Ella Priess  
STATE NOTARY PUBLIC  
Sedgwick County, Kansas  
My Com. Expires Aug. 25, 1976

DRILLERS' LOG

PREMIER PETROLEUM, INC.  
No. 1 Durano  
C NW NW, Sec. 6-28S-3E  
Butler County, Kansas

Elevation: 1326 D.F.

Commenced: 8-28-74  
Completed: 9- 3-74

Surface Casing: 203' of  
8-5/8" cemented w/115 sx  
common cement, 2 Gel, 2 CC.  
8-12-74

FORMATION

DEPTH

Surface Hole	0 - 206
Shale & Lime	206 - 2046
Lime & Shale	2046 - 2189
Shale & Lime	2189 - 2416
Lime & Shale	2416 - 2858
Lime	2858 - 3076
Shale	3076 - 3116
Shale & Sand	3116 - 3140
Lime & Shale	3140 - 3177
Shale & Sand	3177 - 3202 T.D.

RECEIVED  
STATE CORPORATION COMMISSION  
SEP 12 1974  
CONSERVATION DIVISION  
Topeka, Kansas

I do hereby certify that the foregoing statements are true and correct to the best of my knowledge and belief.

D N B DRILLING, INC.

*James L. Donelson*  
JAMES L. DONELSON

STATE OF KANSAS: ss:

Subscribed and sworn to before me, the undersigned, a Notary Public in and for said state, this 6th day of September, 1974.

My Commission Expires:  
August 25, 1976

*Ella Priess*  
Ella Priess, Notary Public

*Ella Priess*  
STATE NOTARY PUBLIC  
Sedgwick County, Kansas  
My Com. Expires Aug. 25, 1976