


SP

WELL PLUGGING RECORD

Give All Information Completely
Make Required Affidavit
Mail or Deliver Report to:
Conservation Division
State Corporation Commission
211 No. Broadway
Wichita, Kansas

NORTH

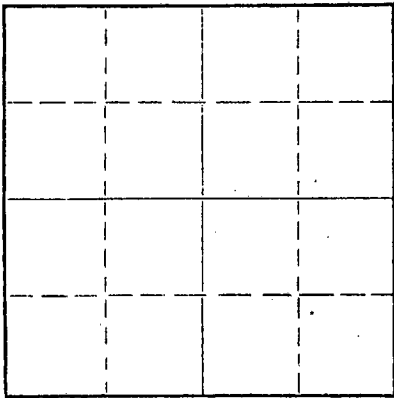

Locate well correctly on above
Section Plat

Butler County, Sec. 2 Twp 28S Rge. 3E (E) (W)
Location as "NE/CNW/SW" or footage from lines Cn/2 S/2 SE
Lease Owner J. A. Allison, et al
Lease Name Showalter Well No. 1
Office Address P.O. Box 1277, El Dorado, Ks.
Character of Well (completed as Oil, Gas or Dry Hole) Dry Hole
Date well completed February 1 19 65
Application for plugging filed July 15 19 65
Application for plugging approved February 1 19 65
Plugging commenced February 1 19 65
Plugging completed February 1 19 65
Reason for abandonment of well or producing formation _____

If a producing well is abandoned, date of last production _____ 19____
Was permission obtained from the Conservation Division or its agents before plugging was commenced? _____

Name of Conservation Agent who supervised plugging of this well Paul Turpin
Producing formation _____ Depth to top _____ Bottom _____ Total Depth of Well 2988 Feet
Show depth and thickness of all water, oil and gas formations.

OIL, GAS OR WATER RECORDS

CASING RECORD

FORMATION	CONTENT	FROM	TO	SIZE	PUT IN	PULLED OUT
Surface				3 5/8	210'	Cemented

Describe in detail the manner in which the well was plugged, indicating where the mud fluid was placed and the method or methods used in introducing it into the hole. If cement or other plugs were used, state the character of same and depth placed, from _____ feet to _____ feet for each plug set.

Plug hole with mud hole to 215'. Set plug, add 1/2 sack hlls, 15 sacks cement, mud to 30'. Set plug with additional hlls and 8 sacks cement.

RECEIVED
STATE CORPORATION COMMISSION
JUL 19 1965
CONSERVATION DIVISION
Wichita, Kansas

(If additional description is necessary, use BACK of this sheet)

Name of Plugging Contractor Economy Drilling, Inc.
Address Augusta, Kansas

STATE OF Kansas COUNTY OF Butler, ss.
J. A. Allison (employee of owner) or (owner or operator) of the above-described well, being first duly sworn on oath, says: That I have knowledge of the facts, statements, and matters herein contained and the log of the above-described well as filed and that the same are true and correct. So help me God.

(Signature) J. A. Allison
Box 1277 EL DORADO KANS.
(Address)

SUBSCRIBED AND SWORN TO before me this 16th day of July, 1965

Florence J. Tolpew
Notary Public.

My commission expires June 22, 1967



2-28-3 E

SP

ROTARY DRILLING LOG

Company: J. A. Allison
 Contractor: Economy Drilling, Inc.
 Total Depth: 2908'
 Commenced: January 25, 1965
 Completed: February 1, 1965

Showalter Well No. 1
 NE of SE of SE
 2-28-3, Butler County,
 Kansas

0	214	surface hole
214	550	shale w/lime strks
550	710	shale w/ lime strks
710	845	shale
845	1277	shale
1277	1614	shale w/lime strks
1614	1775	shale
1775	1880	shale w/lime strks
1880	2175	shale
2175	2203	shale w/lime strks
2203	2313	KC lime
2313	2330	lime
2330	2403	lime & shale
2403	2480	shale & lime
2480	2584	lime & shale
2584	2621	lime & shale
2621	2655	Miss. Lime
2655	2748	Miss. Lime
2748	2800	Miss. Lime
2800	2808	Miss. lime
2808	2825	shale & lime
2825	2915	shale
2915	2933	shale & sand
2933	2973	shale & sand
2973	2998	Arbuckle

RECEIVED
 STATE CORPORATION COMMISSION
 JUL 19 1965
 CONSERVATION DIVISION
 Wichita, Kansas

We certify the above and foregoing to be a true and correct copy of the log on the Showalter Well No. 1, located in Butler County, Kansas.

James S. ...
 Secretary-Treasurer

Subscribed and sworn to before me this 8th day of February, 1965.

James J. ...
 Notary Public

My Commission Expires:
 January 7, 1967