

15-015-30094-00-00

STATE OF KANSAS
STATE CORPORATION COMMISSION


WELL PLUGGING RECORD

FORMATION PLUGGING RECORD

Give All Information Completely
Make Required Affidavit
Mail or Deliver Report to:
Conservation Division
State Corporation Commission
800 Bitting Building
Wichita, Kansas

Strike out upper line
when reporting plug-
ging off formations.

Butler County. Sec. 13 Twp. 28 Rge. 3 (E) (W)
Location as "NE 1/4 NW 1/4 SW 1/4" or footage from lines NW SW SW
Lease Owner Penguin Petroleum, Inc. & W. G. Talbott
Lease Name Dennett Well No. 1
Office Address 709 Petroleum Building
Character of Well (completed as Oil, Gas or Dry Hole) Dry hole
Date well completed November 11, 19 48
Application for plugging filed November 11, 19 48
Application for plugging approved November 12, 19 48
Plugging commenced November 13, 19 48
Plugging completed November 16, 19 48
Reason for abandonment of well or producing formation Dry hole

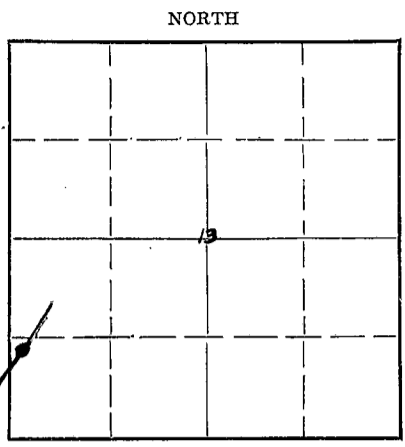

Locate well correctly on above
Section Plat

If a producing well is abandoned, date of last production 19
Was permission obtained from the Conservation Division or its agents before plugging was com-
menced? Yes

Name of Conservation Agent who supervised plugging of this well A. L. Loman
Producing formation Depth to top Bottom Total Depth of Well 3020 Feet
Show depth and thickness of all water, oil and gas formations.

OIL, GAS OR WATER RECORDS

CASING RECORD

Formation	Content	From	To	Size	Put In	Pulled Out
Arbuckle	water		3020'	8 5/8" 5 1/2"	169.35 2923.23	none 2300

Describe in detail the manner in which the well was plugged, indicating where the mud fluid was placed and the method or methods used in introducing it into the hole. If cement or other plugs were used, state the character of same and depth placed, from feet to feet for each plug set.

5 sacks of cement on bottom
mud to 200 feet
12 sacks cement on 10 foot bridge at 190 feet
5 sacks cement cap

RECEIVED
11/26/48
NOV 26 1948
STATE CORPORATION COMMISSION
KANSAS

(If additional description is necessary, use BACK of this sheet)
Correspondence regarding this well should be addressed to W. G. Talbott
Address 709 Petroleum Building

STATE OF KANSAS, COUNTY OF SEDGWICK, ss.

Jack Brown (owner or operator) of the above-described well,
being first duly sworn on oath, says: That I have knowledge of the facts, statements, and matters herein contained and the log of the above-described well as filed and that the same are true and correct. So help me God.

(Signature) Jack Brown
709 Petroleum Building
(Address)

SUBSCRIBED AND SWORN to before me this 24th day of November, 19 48

My commission expires October 13, 1952

22-2625 2-48-15M

PLUGGING
FILE SEC 13 T 28 R 36
BOOK PAGE 67 LINE 35

Notary Public.

15-015-30094-00-00

Company: Penguin Petroleum, Inc. & W. G. Talbott
Farm: Dennett #1

Section 13, T 28, R 3 E
NW SW SW
Butler County, Kansas
Rotary Tools
Elevation: 1316' R.B.
Total Depth: 3020' HFW
D & A

Comm: October 20, 1948
Comp: November 11, 1948

Contractor: Penguin Petroleum, Inc.

Casing: 8" @ 160'
5 1/2" @ 2920'

0-6	soil clay
-20	slate
-55	shale and lime shells
-80	lime
-90	shale
-110	red shale
-280	lime
-520	shale and lime
-690	lime and shale
-900	shale
-1125	shale and shells
-1465	shale and lime
-1670	lime and shale
-1740	lime broken
-1905	shale and shells
-2025	shale and lime
-2160	lime
-2300	shale and lime
-2305	shale
-2355	lime
-2435	shale and shells
-2440	lime
-2480	shale and shells
-2615	lime and shale
-2680	lime
-2690	shale
-2740	lime broken
-2888	lime
-2989	shale
-2995	sand (small show oil)
-2998	sandy shale
-3009	sand and shale
-3018	sand
-3020	dolomite

R.U.S.T. ,2920'

2989
1316
1673

2285
1316
69

Total Depth: 3020' HFW

Tops:	Kansas City	@ 2285'
	Mississippian	@ 2746'
	Kinderhook	@ 2890'
	Simpson sandstone	@ 2989'
	Arbuckle dolomite	@ 3018' HFW

RECEIVED

Conservation

NOV 12 1948

STATE CORPORATION
COMMISSION
KANSAS

Water record: 2 BW 55'
HFW 120'
HFW 3020'

Certified to be true copy of the well log as indicated on daily drilling reports.

Penguin Petroleum, Inc.

by Jack Brown

Subscribed and sworn to before me, the undersigned, a Notary Public in and for Sedgwick County, Kansas, this 11th day of November, 1948.

My Commission Expires:

October 13, 1952

PLUGGING
FILE SEC 13T28R3E
BOOK PAGE 67 LINE 35

D. D. Strickland
Notary Public