


15-015-00185-00-00

WELL PLUGGING RECORD

Give All Information Completely  
Make Required Affidavit  
Mail or Deliver Report to:  
Conservation Division  
State Corporation Commission  
211 No. Broadway  
Wichita, Kansas

Butler County, Sec. 12 Twp. 28S Rge. 3 (E) (W)

NORTH

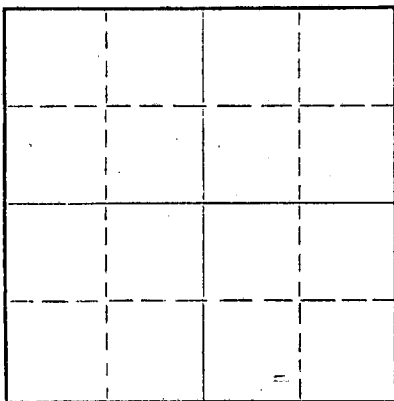

Locate well correctly on above Section Plat

Location as "NE/CNW/SW" or footage from lines NE NE NE  
Lease Owner National Cooperative Refinery Association  
Lease Name Branson Well No. 1  
Office Address 305 Rule Building, Wichita, Kansas  
Character of Well (completed as Oil, Gas or Dry Hole) Dry Hole  
Date well completed February 24, 1958  
Application for plugging filed February 24, 1958  
Application for plugging approved February 25, 1958  
Plugging commenced February 24, 1958  
Plugging completed February 24, 1958  
Reason for abandonment of well or producing formation Dry Hole

If a producing well is abandoned, date of last production \_\_\_\_\_ 19\_\_\_\_  
Was permission obtained from the Conservation Division or its agents before plugging was commenced? Yes

Name of Conservation Agent who supervised plugging of this well Gene Graham  
Producing formation \_\_\_\_\_ Depth to top \_\_\_\_\_ Bottom \_\_\_\_\_ Total Depth of Well 2980 Feet  
Show depth and thickness of all water, oil and gas formations.

OIL, GAS OR WATER RECORDS

CASING RECORD

FORMATION	CONTENT	FROM	TO	SIZE	PUT IN	PULLED OUT
				8-5/8"	216'	None-Cemented


Describe in detail the manner in which the well was plugged, indicating where the mud fluid was placed and the method or methods used in introducing it into the hole. If cement or other plugs were used, state the character of same and depth placed, from \_\_\_\_\_ feet to \_\_\_\_\_ feet for each plug set.  
Mudded hole to 210'. Dumped 15 sacks of cement to 185'.  
Mudded hole to 30', dumped 15 sacks of cement.  
Filled up to 2' below surface.

RECEIVED  
STATE CORPORATION COMMISSION  
3/14/58  
MAR 14 1958  
CONSERVATION DIVISION  
Wichita, Kansas

(If additional description is necessary, use BACK of this sheet)  
Name of Plugging Contractor Winne Oil Company  
Address 3856 North Oliver, Wichita, Kansas

STATE OF Kansas, COUNTY OF Sedgwick, ss.  
C. R. Sears (employee of owner) or (owner or operator) of the above-described well, being first duly sworn on oath, says: That I have knowledge of the facts, statements, and matters herein contained and the log of the above-described well as filed and that the same are true and correct. So help me God.  
(Signature) C. R. Sears (C. R. Sears)  
305 Rule Building, Wichita, Kansas (Address)

SUBSCRIBED AND SWORN to before me this 13th day of March, 19 58  
My commission expires November 26, 1960.  
Nell McComb Notary Public.

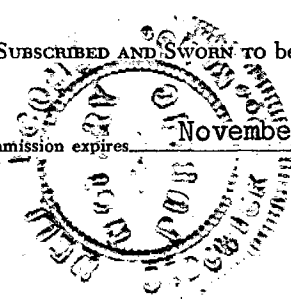

PLUGGING  
FILE SEC. 12 T. 28R. 3E  
BOOK PAGE 85 LINE 8

15-015-00185-00-00

WELL LOG  
WINNE OIL COMPANY INC.  
3856 N Oliver  
Wichita, Kans.

COMPANY-National Co-Op Refining Association

Sec 12-28-3  
NE-NE-NE  
Butler County, Kans.  
Elevation 1252 D F

Total Depth 2980

Cbmm. 2-12-58 Comp. 2-24-58

CONTRACTOR-Winne Oil Company Inc.

Casing 8 5/8 W200 S/Cement 216'

Surface Hole	216
Lime	330
Lime & Shale	560
Shale & Shell	1000
Shale & Lime	1160
Shale & Shells	1400
Lime & Shale	1705
Shale & Shells	1925
Lime & Shale	2103
Lime Shells & Shell	2238
Lime & Shale	2340
Lime	2582
Lime & Shale	2647
Shale & Shells	2701
Lime & Shale	2776
Lime	2866
Lime & Shale	2906
Shale	2951
Lime & Shale	2980

RECEIVED  
STATE CORPORATE COMMISSION

MAR 14 1958

CONSERVATION DIVISION  
Wichita, Kansas

TOPS:	
Lansing	1858
Kansas City	2210
Mississippi	2680
Kinderhook	2846
Simpson	2943
Arbuckle	2960

PLUGGING  
FILE SEC 12 T 28 R 3E  
BOOK PAGE 85 LINE 8