


WELL PLUGGING RECORD

Give All Information Completely
Make Required Affidavit
Mail or Deliver Report to:
Conservation Division
State Corporation Commission
800 Bitting Building
Wichita, Kansas

NORTH

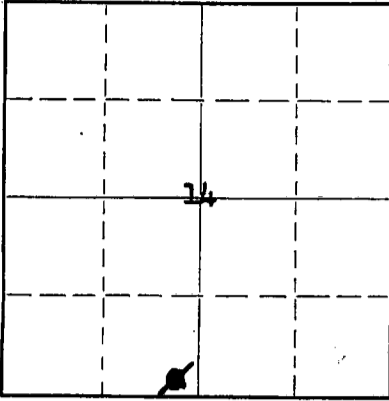

Locate well correctly on above Section Plat

Butler County. Sec. 14 Twp. 28S Rge. 3 (E) (W)
Location as "NE/CNW $\frac{1}{4}$ SW $\frac{1}{4}$ " or footage from lines SE $\frac{1}{4}$ SE $\frac{1}{4}$ SW $\frac{1}{4}$
Lease Owner John P. Gaty
Lease Name Lackey Well No. 1
Office Address 11 Cypress Drive, Wichita, Kansas
Character of Well (completed as Oil, Gas or Dry Hole) Oil
Date well completed August 14 1947
Application for plugging filed June 5 1950
Application for plugging approved June 5 1950
Plugging commenced June 14 1950
Plugging completed June 15 1950
Reason for abandonment of well or producing formation Water
If a producing well is abandoned, date of last production December 1949
Was permission obtained from the Conservation Division or its agents before plugging was commenced? Yes

Name of Conservation Agent who supervised plugging of this well A. L. Loman
Producing formation Simpson Depth to top 2993 Bottom 3003 Total Depth of Well 3003 Feet
Show depth and thickness of all water, oil and gas formations.

OIL, GAS OR WATER RECORDS

CASING RECORD

Formation	Content	From	To	Size	Put In	Pulled Out

Describe in detail the manner in which the well was plugged, indicating where the mud fluid was placed and the method or methods used in introducing it into the hole. If cement or other plugs were used, state the character of same and depth placed, from.....feet tofeet for each plug set.

3 sacks cement 3003' to 2993'
Mud from 2993' to 135'
15' rock bridge 135' to 120'
10 sacks cement 120' to 110'
Mud to cellar
5 sacks cement in cellar

RECEIVED

Conservation Div.
7/11/50
JUL 11 1950

STATE CORPORATION
COMMISSION
KANSAS

(If additional description is necessary, use BACK of this sheet)

Correspondence regarding this well should be addressed to John P. Gaty
Address 11 Cypress Drive
Wichita, Kansas

STATE OF Kansas, COUNTY OF Sedgwick, ss. Max Howell (employee of owner) or (owner or operator) of the above-described well, being first duly sworn on oath, says: That I have knowledge of the facts, statements, and matters herein contained and the log of the above-described well as filed and that the same are true and correct. So help me God.

(Signature) Max Howell
210 N. Edgemon
(Address)

SUBSCRIBED AND SWORN to before me this 30th day of June, 1950

My commission expires Feb 4, 1952 Edue G. Hayes Notary Public.

PLUGGING
FILE SEC 14 T 28 R 3E
BOOK PAGE 9 LINE 20

15-015-19829-00-00

DRILLING LOG

Company: John P. Gaty
Farm: Lackey #1
Commenced: July 26, 1947
Completed: August 14, 1947

Location: SE SE SW
Section 14-288-3E
Butler County, Kansas

Contractor: W. G. Talbott
Casing: 8-5/8" 160'
5-1/2" 2980'

Rotary Tools
Total Depth: 3003'

0-155	Surface Hole
-640	Line
-705	Line
-1175	Shale
-2020	Shale and Lime
-2140	Line
-2350	Line and Shale
-2485	Line
-2835	Line and Shale
-2900	Line
-2914	Line and Shale
-2980	Shale (Rotary T. D.)
-2994	Black Shale
-3003	Sand T. D.

RECEIVED
 JUL 11 1950
 SECTION

PLUGGING
 FILE SEC 14 T 28 R 36
 PAGE 9 LINE 20