




Give All Information Completely
Make Required Affidavit
Mail or Deliver Report to:
Conservation Division
State Corporation Commission
211 No. Broadway
Wichita, Kansas

WELL PLUGGING RECORD

NORTH

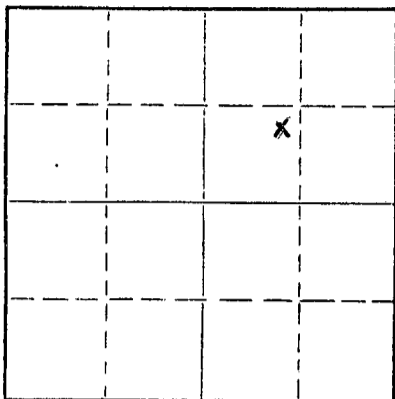

Locate well correctly on above
Section Plat

Butler County. Sec. 23 Twp. 28 Rge. 3 (E) (XXX)
Location as "NE/CNW/SW" or footage from lines NE SW NE
Lease Owner W. G. Talbott
Lease Name Barnhart Well No. 3
Office Address 302 Insurance Bldg., Wichita, Kansas
Character of Well (completed as Oil, Gas or Dry Hole) oilwell
Date well completed 19____
Application for plugging filed 19____
Application for plugging approved 19____
Plugging commenced 10-25-65 19____
Plugging completed 11-2-65 19____
Reason for abandonment of well or producing formation depleted

If a producing well is abandoned, date of last production 19____
Was permission obtained from the Conservation Division or its agents before plugging was commenced? yes

Name of Conservation Agent who supervised plugging of this well Paul Turpin
Producing formation _____ Depth to top _____ Bottom _____ Total Depth of Well 2997 Feet
Show depth and thickness of all water, oil and gas formations.

OIL, GAS OR WATER RECORDS

CASING RECORD

FORMATION	CONTENT	FROM	TO	SIZE	PUT IN	PULLED OUT
				8 5/8	169	none
				5 1/2	2960	2560.06

Describe in detail the manner in which the well was plugged, indicating where the mud fluid was placed and the method or methods used in introducing it into the hole. If cement or other plugs were used, state the character of same and depth placed, from _____ feet to _____ feet for each plug set.

Fill hole with rock from 2997' to 2950' and dump 5 sacks cement.
Set 15' rock bridge from 200' to 185' and dump 20 sacks cement.
Mud hole to 40', rock bridge to 30' and dump 10 sacks cement.

RECEIVED
STATE CORPORATION COMMISSION
11/15/65
NOV 15 1965
CONSERVATION DIVISION
WICHITA, KANSAS

Name of Plugging Contractor Flint Engineering & Construction Company
Address Box 950, El Dorado, Kansas

STATE OF KANSAS, COUNTY OF BUTLER, ss.
_____, (employee of owner) or (owner or operator) of the above-described well, being first duly sworn on oath, says: That I have knowledge of the facts, statements, and matters herein contained and the log of the above-described well as filed and that the same are true and correct. So help me God.

(Signature) Janis Bawdle
El Dorado, Kansas
(Address)



9-27-67

11th day of November, 1965
Ronald L. Hanson
Notary Public.

9

15-015-19846-00-00

Company: Talbott & Sohio
Farm: Barnhart #3
Comm: June 7, 1949
Comp: June 19, 1949
Contractor: Penguin Petroleum, Inc.

Section 23, T 28 S, R 3 E
330' frWL 230' frNL SW NE
Butler County, Kansas
Rotary Tools
Elevation: 1318' D.F.
Total Depth: 2996 1/2'
Initial Potential: 50 BOPD

Casing: 8 5/8" @ 168.73'
5 1/2" @ 2959.52'

0-40	Lime	
-120	Shale and lime shells	
-132	Sand	
-145	Shale and shells	
-165	Lime	
-250	Lime broken	
-315	Lime broken	
-330	Red rock	
-340	Sand hard	
-410	Broken lime	
-700	Shale and lime	
-835	Shale	
-990	Sandy shale	
-1005	Sand	
-1400	Shale and shells	
-1450	Broken lime	
-1780	Shale and lime	
-1895	Shale	
-1945	Broken lime	
-2080	Lime	
-2125	Lime and shale	
-2365	Lime	
-2415	Lime and shale	
-2455	Shale	
-2502	Lime	
-2762	Lime and shale	
-2805	Lime	
-2885	Lime and shale	
-2888	Lime	
-2960	Shale	R.T.D. 2960'
-2981	Shale dark	
-2996 1/2	Sand	

Total Depth 2996 1/2'

1st free oil 2986-88 1/2'
2 bbl. oil per hr. @ 2996 1/2'

Tops: Kansas City limestone	@ 2305'
Mississippian limestone	@ 2755'
Kinderhook	@ 2888'
Simpson Sandstone	@ 2981'

Certified to be a true copy of the well log as indicated on daily drilling reports.

PENGUIN PETROLEUM, INC.

by Jack Brown

Subscribed and sworn to before me, the undersigned, a Notary Public in and for Sedgwick County, Kansas, this 12 day of July, 1949.

My Commission Expires:
October 13, 1952

B.D. Strickland
Notary Public