


Give All Information Completely
Make Required Affidavit
Mail or Deliver Report to:
Conservation Division
State Corporation Commission
212 No. Market
Wichita, Kansas

WELL PLUGGING RECORD

NORTH

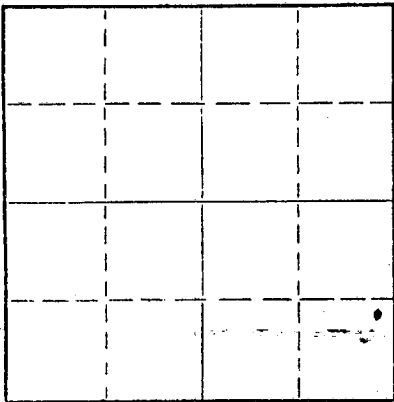

Locate well correctly on above
Section Plat

Graham County. Sec. 17 Twp. 8 Rge. 25 (E) W (W)

Location as "NE/CNW%SW%" or footage from lines NE SE SE

Lease Owner Empire Drilling Co.

Lease Name Madden Davis Well No. ~~834~~ B-4

Office Address Wichita, Kansas 650 4th Natl. Bank Bldg.

Character of Well (completed as Oil, Gas or Dry Hole) _____

Date well completed July 71 1954

Application for plugging filed Dec. 28 1965

Application for plugging approved Dec. 28 1965

Plugging commenced Feb. 4 1966

Plugging completed Feb. 5 1966

Reason for abandonment of well or producing formation Lack of oil

If a producing well is abandoned, date of last production January 4 1966

Was permission obtained from the Conservation Division or its agents before plugging was commenced? Yes

Name of Conservation Agent who supervised plugging of this well Nichols

Producing formation Lansing Kansas City Depth to top 3636 Bottom 3808 Total Depth of Well 3808 Feet

Show depth and thickness of all water, oil and gas formations.

OIL, GAS OR WATER RECORDS

CASING RECORD

FORMATION	CONTENT	FROM	TO	SIZE	PUT IN	PULLED OUT
	Surface	-0-	188	8 5/8"	171'	-0-
Lansing Kansas City	Lime			5 1/2"	3798'	1197.20'

Describe in detail the manner in which the well was plugged, indicating where the mud fluid was placed and the method or methods used in introducing it into the hole. If cement or other plugs were used, state the character of same and depth placed, from 3808 feet to surface feet for each plug set.
Sanded up to 3650' dump 5 sacks of cement on bottom. Pulled pipe pump 20 sacks of mud & 100 sacks of cement in hole.
Well completed.

RECEIVED
STATE CORPORATION COMMISSION
FEB 28 1966
CONSERVATION DIVISION
Wichita, Kansas
2/28/66

(If additional description is necessary, use BACK of this sheet)
Name of Plugging Contractor Barnes & Sons Pipe Pulling Co.
Address P.O. Box 313 Russell, Kansas


STATE OF KANSAS, COUNTY OF SEDGWICK, ss.

Theodore Gore (owner or operator) of the above-described well, being first duly sworn on oath, says: That I have knowledge of the facts, statements, and matters herein contained and the log of the above-described well as filed and that the same are true and correct. So help me God.

(Signature) Theodore Gore
650 4th Natl. Bank Bldg., Wichita, Ks. 67202
(Address)

SUBSCRIBED AND SWORN TO before me this 23th day of February, 1966.

Sandra Kay Peer
Sandra Kay Peer Notary Public.

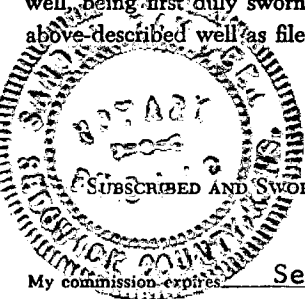

September 14, 1968

15-065-02786-0220
WELL LOG

COMPANY

CONTRACTOR

FARM

LOCATION

COMMENCED

COMPLETED

RECEIVED
STATE MINERAL COMMISSION

DEC 29 1965

12/29/65

CONSERVATION DIVISION
Wichita, Kansas

EMPIRE DRILLING COMPANY

EMPIRE DRILLING COMPANY

MADDEN DAVIS 1B # 4

NW SE SE 17-8-25W
GRAHAM COUNTY, KANSAS

6-28-54

7-7-54

XX

0	TO	188	SURFACE HOLE.
188	TO	395	SHALE
395	TO	1030	SHALE AND SAND
1030	TO	1400	SHALE, SAND AND SHELLS
1400	TO	2050	SHALE
2050	TO	2085	ANHYDRITE
2085	TO	2135	SHALE
2135	TO	2375	SHALE AND SHELLS
2375	TO	2510	SHALE
2510	TO	2775	SHALE AND SHELLS
2775	TO	2890	LIME AND SHALE
2890	TO	3000	SHALE AND LIME
3000	TO	3085	SHALE AND SHELLS
3085	TO	3165	LIME AND SHALE
3165	TO	3435	LIME
3435	TO	3615	LIME AND SHALE
3615	TO	3808	LIME
3808			RTD

XX

SET 171' OF 8 5/8" SURFACE CASING, CEMENTED WITH 110 SACKS OF EM CEMENT
ELEVATION: 2352 K.B.

TOPS: HEEBNER 3599'; TORONTO 3619'; L KC 3636'; RTD 3808'

XB
SET 3798' OF 5 1/2" CASING, CEMENTED WITH 75 SACKS OF CEMENT