


15-065-20628-000

Give All Information Completely  
Make Required Affidavit  
Mail or Deliver Report to:  
Conservation Division  
State Corporation Commission  
211 No. Broadway  
Wichita, Kansas

WELL PLUGGING RECORD

NORTH

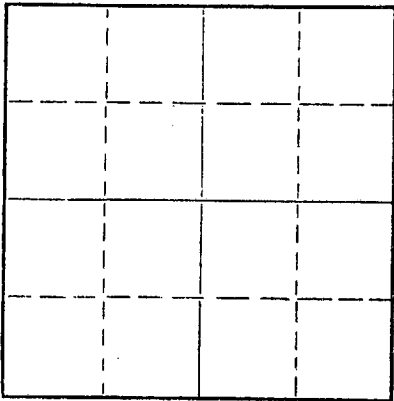

Locate well correctly on above  
Section Plat

Graham County. Sec. 25 Twp. 8 Rge. 25W (E) (W)  
Location as "NE/CNW/SW" or footage from lines C NE SW  
Lease Owner Levitt, etal (Chief Drilling Co., Inc., Operator  
Lease Name L&R Schamberger Well No. 2  
Office Address Suite 905 Century Plaza, Wichita, Kans. 67202  
Character of Well (completed as Oil, Gas or Dry Hole) Dry Hole  
Date well completed 8/24/73 19\_\_  
Application for plugging filed 8/23/73 19\_\_  
Application for plugging approved 8/23/73 19\_\_  
Plugging commenced 8/24/73 19\_\_  
Plugging completed 8/24/73 19\_\_  
Reason for abandonment of well or producing formation \_\_\_\_\_

If a producing well is abandoned, date of last production \_\_\_\_\_ 19\_\_  
Was permission obtained from the Conservation Division or its agents before plugging was commenced? Yes

Name of Conservation Agent who supervised plugging of this well William Nichols  
Producing formation \_\_\_\_\_ Depth to top \_\_\_\_\_ Bottom \_\_\_\_\_ Total Depth of Well 3955 Feet  
Show depth and thickness of all water, oil and gas formations.

OIL, GAS OR WATER RECORDS

CASING RECORD

FORMATION	CONTENT	FROM	TO	SIZE	PUT IN	PULLED OUT
		0'	222'	8 5/8"		

Describe in detail the manner in which the well was plugged, indicating where the mud fluid was placed and the method or methods used in introducing it into the hole. If cement or other plugs were used, state the character of same and depth placed, from \_\_\_\_\_ feet to \_\_\_\_\_ feet for each plug set.

Well plugged through drill pipe @ 1150 feet w/110 cubic feet cement.  
Well plugged through driol pipe @ 245 feet w/30 cubic feet cement.  
Well plugged through drill pipe @ 40 feet w/10 cubic feet cement.

RECEIVED  
STATE CORPORATION COMMISSION

AUG 28 1973

CONSERVATION DIVISION  
Wichita, Kansas 8/28/73

Name of Plugging Contractor Chief Drilling Co., Inc. (If additional description is necessary, use BACK of this sheet)  
Address Suite 905 Century Plaza, Wichita, Kansas 67202

STATE OF KANSAS, COUNTY OF SEDGWICK, ss.  
Jim Robinson (Employee of owner) or (owner or operator) of the above-described

well, being first duly sworn on oath, says: That I have knowledge of the facts, statements, and matters herein contained and the log of the above-described well as filed and that the same are true and correct. So help me God.

(Signature) Jim Robinson  
Suite 905 Century Plaza, Wichita, Kansas (Address)

Subscribed and Sworn to before me this 27th day of August, 19 73  
Virginia S. Fabian  
Virginia S. Fabian Notary Public.  
My commission expires August 5, 1975



15-065-20628-00-00

WELL LOG

LEVITT, ETAL  
(Chief Drilling Co., Inc., Operator)  
Suite 905 Century Plaza  
Wichita, Kansas 67202

#2 L&R SCHAMBERGER  
C NE SW Sec. 25-8-25W  
Graham County, Kansas

CONTRACTOR: Chief Drilling Co., Inc.  
CASING RECORD: Set 215' of 8 5/8"  
w/150 sacks common quick set cement

COMMENCED: 8/17/73  
COMPLETED: 8/24/73

<u>FORMATION</u>	<u>FROM</u>	<u>TO</u>	<u>ELEVATION</u>
Surface Sand & Gravel	0	225	2419 Gr.
Shale & Sand	225	248	2421 D.F.
Shale	248	1115	2424 K.B.
Sand & Shale	1115	2145	
Anhydrite	2145	2179	
Shale	2179	2565	
Shale & Shells	2565	2815	
Shale & Lime	2815	2964	
Lime & Shale	2964	3500	
Lime	3500	3917	
K.C. Lime	3917	3937	
Lime	3937	3955	
Total Depth	3955		

FORMATION TOPS

Anhydrite	2145 +	279
Base Anhy.	2179 +	245
Heebner	3712 -	1288
Toronto	3736 -	1312
Lansing	3756 -	1332
R.T.D.	3955 -	1531

STATE OF KANSAS, COUNTY OF SEDGWICK) ss:

I hereby certify that the above is a true and correct copy of the Driller's Log of the well drilled in the C NE SW of Section 25-8-25W, Graham County, Kansas, to the best of my knowledge and belief.

CHIEF DRILLING CO., INC.

*Jim Robinson*

Jim Robinson, Vice President

Subscribed and sworn to before me this 27th day of August, 1973.

*Virginia S. Fabian*

Virginia S. Fabian, Notary Public

MY COMMISSION EXPIRES:

