


Give All Information Completely
Make Required Affidavit
Mail or Deliver Report to:
Conservation Division
State Corporation Commission
211 No. Broadway
Wichita, Kansas

WELL PLUGGING RECORD

Graham County. Sec. 12 Twp. 8 Rge. 24W (E) (W)
Location as "NE/CNW%SW%" or footage from lines W/2 SE SE
Lease Owner Chief Drilling Co., Inc.
Lease Name Evans #1 Well No. _____
Office Address Suite 905 Century Plaza, Wichita, Kansas
Character of Well (completed as Oil, Gas or Dry Hole) Dry hole
Date well completed October 5, 1970 19____
Application for plugging filed October 5, 1970 19____
Application for plugging approved October 5, 1970 19____
Plugging commenced October 5, 1970 19____
Plugging completed October 5, 1970 19____
Reason for abandonment of well or producing formation dry hole

NORTH

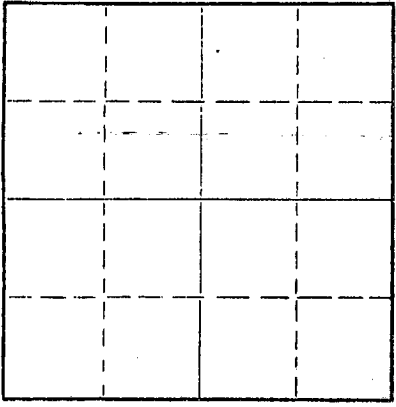

Locate well correctly on above
Section Plat

If a producing well is abandoned, date of last production _____ 19____
Was permission obtained from the Conservation Division or its agents before plugging was commenced? Yes

Name of Conservation Agent who supervised plugging of this well W. L. Nichols
Producing formation _____ Depth to top _____ Bottom _____ Total Depth of Well 3740 Feet
Show depth and thickness of all water, oil and gas formations.

OIL, GAS OR WATER RECORDS

CASING RECORD

FORMATION	CONTENT	FROM	TO	SIZE	PUT IN	PULLED OUT
		0	216	8 5/8"		

Describe in detail the manner in which the well was plugged, indicating where the mud fluid was placed and the method or methods used in introducing it into the hole. If cement or other plugs were used, state the character of same and depth placed, from _____ feet to _____ feet for each plug set.

Plugged through drill pipe @ 1025 w/100 sacks cement
Plugged through drill pipe @ 240' w/25 sacks cement
Plugged through drill pipe @ 40' w/10 sacks cement


RECEIVED
STATE CORPORATION COMMISSION
OCT 6 1970
CONSERVATION DIVISION
Wichita, Kansas
10-6-1970

(If additional description is necessary, use BACK of this sheet)
Name of Plugging Contractor Chief Drilling Co., Inc.
Address Suite 905 Century Plaza, Wichita, Kansas 67202

STATE OF KANSAS, COUNTY OF SEDGWICK, ss.
Jim Robinson (employee of owner) or ~~(owner or operator)~~ of the above-described well, being first duly sworn on oath, says: That I have knowledge of the facts, statements, and matters herein contained and the log of the above-described well as filed and that the same are true and correct. So help me God.

(Signature) Jim Robinson
Suite 905 Century Plaza, Wichita, Kansas 67202
(Address)

Subscribed and sworn to before me this 5th day of October, 19 70
2/16/74

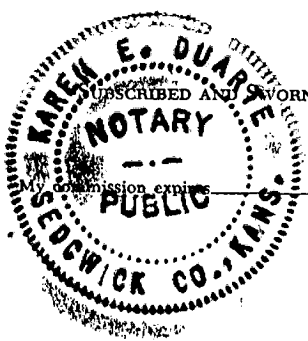

Karen E. Duarte
Karen E. Duarte Notary Public.

15-065-20377-00-00

RECEIVED
STATE CORPORATION COMMISSION
OCT 13 1970
CONSERVATION DIVISION #1
EVANS
Wichita, Kansas

WELL LOG

CHIEF DRILLING CO., INC.
Suite 905 Century Plaza
Wichita, Kansas 67202

10-13-1970

W/2 SE SE Sec. 12-8-24W
Graham County

CONTRACTOR: Company Tools
CASING RECORD: Set 8 5/8" casing @ 216' w/135 sacks common quickset

COMMENCED: 9/29/70
COMPLETED: 10/5/70

<u>FORMATION</u>	<u>FROM</u>	<u>TO</u>	<u>ELEVATION:</u> 2253 K.B.
Rock	0	30	
Shale	30	216	
Shale & shells	216	900	
Shale & lime	900	1340	
Shale & shells	1340	1454	
Sand	1454	1654	
Red bed	1654	1893	
Anhydrite	1893	1902	
Anhydrite	1902	1925	
Shale & shells	1925	2180	
Shale & lime	2180	3740	
Total depth	3740		

<u>FORMATION TOPS</u>	
Anhydrite	1893 + 360
Heebner	3479 - 1226
Toronto	3504 - 1251
Lansing	3517 - 1264
Base K.C.	3731 - 1478
Total Depth	3740 - 1487

STATE OF KANSAS, COUNTY OF SEDGWICK) ss:

I hereby certify that the above is a true and correct copy of the Driller's Log of the well drilled in the W/2 SE SE of Section 12-8-24W, Graham County, Kansas, to the best of my knowledge and belief.

CHIEF DRILLING CO., INC.

Jim Robinson
Jim Robinson, Office Manager

Subscribed and sworn to before me this 12th day of October, 1970.

Karen E. Duarte
Karen E. Duarte, Notary Public

