


Give All Information Completely
Make Required Affidavit
Mail or Deliver Report to:
Conservation Division
State Corporation Commission
211 No. Broadway
Wichita, Kansas

WELL PLUGGING RECORD

Graham County, Sec. 12 Twp. 8S Rge. (E) 24 (W)

Location as "NE/CNW%SW%" or footage from lines C S/2 SE NE
Lease Owner Chief Drilling Co., Inc.
Lease Name HUTTON Well No. 2
Office Address Box 797 - Great Bend, Kansas
Character of Well (completed as Oil, Gas or Dry Hole) Dry Hole
Date well completed 10/219 65
Application for plugging filed 10/219 65
Application for plugging approved 10/219 65
Plugging commenced 10/219 65
Plugging completed 10/219 65
Reason for abandonment of well or producing formation Dry Hole

NORTH

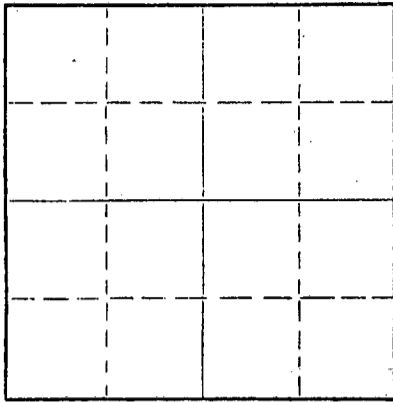

Locate well correctly on above
Section Plat

If a producing well is abandoned, date of last production 19____
Was permission obtained from the Conservation Division or its agents before plugging was commenced? Yes

Name of Conservation Agent who supervised plugging of this well W.L. Nichols - Moreland, Kansas
Producing formation _____ Depth to top _____ Bottom _____ Total Depth of Well 3780 Feet
Show depth and thickness of all water, oil and gas formations.

OIL, GAS OR WATER RECORDS

CASING RECORD

FORMATION	CONTENT	FROM	TO	SIZE	PUT IN	PULLED OUT
		0	200	8-5/8"	200	none

Describe in detail the manner in which the well was plugged, indicating where the mud fluid was placed and the method or methods used in introducing it into the hole. If cement or other plugs were used, state the character of same and depth placed, from _____ feet to _____ feet for each plug set.

Wooden plug set @ 550'
Mixed 20 sacks cement through drill pipe
Wooden plug set @ 185'
Mixed 20 sacks cement through drill pipe
Hulls and wooden plug set @ 40'
Mixed 10 sacks cement through drill pipe

RECEIVED
STATE CORPORATION COMMISSION

OCT 5 1965
10-5-1965
CONSERVATION DIVISION
Wichita, Kansas

(If additional description is necessary, use BACK of this sheet)
Name of Plugging Contractor Chief Drilling Co., Inc.
Address Box 797 - Gt. Bend, Kansas

STATE OF KANSAS, COUNTY OF BARTON, ss.
V. Richard Hoover, President (employee of owner) or (owner or operator) of the above-described well, being first duly sworn on oath, says: That I have knowledge of the facts, statements, and matters herein contained and the log of the above-described well as filed and that the same are true and correct. So help me God.

(Signature) V. Richard Hoover CHIEF DRILLING CO., INC.
Box 797 - Gt. Bend, Kansas (Address)

SUBSCRIBED AND SWORN to before me this 4th day of October, 1965
My commission expires Jan. 26, 1967



Carmen R. Cook
Carmen R. Cook, Notary Public.

WELL LOG

Chief Drilling Co., Inc.
 Box 797
 Great Bend, Kansas

HUTTON #2
 C S/2 SE NE Sec. 12-8S-24W
 Graham County, Kansas

Contractor: Chief Drilling Co., Inc.

Commenced: 9-25-65
 Completed: 10-2-65

Casing Record: 8-5/8" @ 200' w/175 sacks Sunset.

DRY & ABANDONED

RECEIVED
 STATE CORPORATION COMMISSION
 OCT 5 1965
 10-5-1965
 CONSERVATION DIVISION
 Wichita, Kansas

<u>FORMATION</u>	<u>FROM</u>	<u>TO</u>	<u>ELEVATION</u>
Shale	0	1954	2288 Gr.
Anhydrite	1954	1985	2290 D.F.
Shale	1985	2295	2293 K.B.
Shale & Lime	2295	2990	
Lime	2990	3520	
Lime & Shale	3520	3558	
Lime	3558	3780	
Total Depth	3780		
			<u>FORMATION TOPS</u>
		Anhydrite	1955 + 338
		Heebner	3520 -1227
		Toronto	3543 -1250
		Lansing	3558 -1265
		Base Kansas City	3774 -1481
		Total Depth	3780 -1487

STATE OF KANSAS, COUNTY OF BARTON) SS

I hereby certify that the above is a true and correct copy of the Driller's Log of the well drilled in the C S/2 SE NE Sec. 12-8S-24W, Graham County, Kansas, to the best of my knowledge and belief.

CHIEF DRILLING CO., INC.

V. Richard Hoover
 V. Richard Hoover, President

Subscribed and sworn to before me this 4th day of October, 1965.

Carmen R. Cook
 Carmen R. Cook, Notary Public



My commission expires: Jan. 26, 1967.