


Give All Information Completely  
Make Required Affidavit  
Mail or Deliver Report to:  
Conservation Division  
State Corporation Commission  
800 Bittig Building  
Wichita, Kansas

WELL PLUGGING RECORD

NORTH

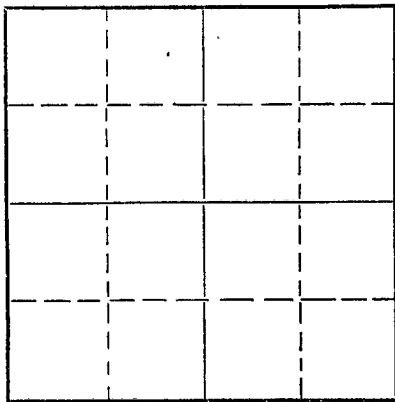

Locate well correctly on above Section Plat

Graham County, Sec. 17 Twp. 8 Rge. 24 (E) (W)  
Location as "NE/CNW%SW%" or footage from lines SW-SW-SE  
Lease Owner Peel-Hardman Oil Oper. - Box 359-Hoisington, Ks.  
Lease Name Stinemetz # Well No. 1  
Office Address P.O. Box 359 - Hoisington, Kansas  
Character of Well (completed as Oil, Gas or Dry Hole) Dry Hole  
Date well completed 12-6 1955  
Application for plugging filed 12-6 1955  
Application for plugging approved 12-6- 1955  
Plugging commenced 12-6 1955  
Plugging completed 12-6 1955  
Reason for abandonment of well or producing formation Dry Hole

If a producing well is abandoned, date of last production 19  
Was permission obtained from the Conservation Division or its agents before plugging was commenced? Yes

Name of Conservation Agent who supervised plugging of this well Petty - State Plugger - Hays, Kansas  
Producing formation \_\_\_\_\_ Depth to top \_\_\_\_\_ Bottom \_\_\_\_\_ Total Depth of Well 4365 Feet  
Show depth and thickness of all water, oil and gas formations.

OIL, GAS OR WATER RECORDS

CASING RECORD

FORMATION	CONTENT	FROM	TO	SIZE	PUT IN	PULLED OUT
		0'	193'	8-5/8"	193'	none

Describe in detail the manner in which the well was plugged, indicating where the mud fluid was placed and the method or methods used in introducing it into the hole. If cement or other plugs were used, state the character of same and depth placed, from \_\_\_\_\_ feet to \_\_\_\_\_ feet for each plug set.

From 4365' to 181 1/2' Heavy Rotary Mud.  
" 181 1/2' " 180 Wooden Plug.  
" 180 " 105 1/2 sks. Hulls 15 sks. cement.  
" 105 " 41 1/2' Heavy Rotary Mud.  
" 41 1/2' " 40 Wooden Plug.  
" 40 " 6 1/2 sks. Hulls, 15 sks. cement.  
" 6 " Surface to cellar.

(If additional description is necessary, use BACK of this sheet)

Name of Plugging Contractor ~~XXXXXXXXXXXXXXXXXXXX~~ Peel Brothers, Inc.  
Address Box 88 - Hoisington, Kansas

STATE OF Kansas, COUNTY OF Barton, ss.  
\_\_\_\_\_  
(employee of owner) or (owner or operator) of the above-described well, being first duly sworn on oath, says: That I have knowledge of the facts, statements, and matters herein contained and the log of the above-described well as filed and that the same are true and correct. So help me God.

(Signature) [Signature]  
Box 88 - Hoisington, Kansas  
(Address)

SUBSCRIBED AND SWORN to before me this 20 day of December 1955

My commission expires September 28, 1957

Notary Public.

**PLUGGING**  
FILE SEC. 17 T. 8 R. 24 W  
BOOK PAGE 22 LINE 31

WICHITA, KANSAS  
DIVISION  
12-27-55

15 065-00722-00-00

DRILLER'S LOG

Company: Peel-Hardman Oil Operators

SW-SW-SE

Sec: 17, Twn: 8, Rge: 24

Farm: Stinemetz Well No: 1

Total Depth: 4365'

County: Graham,  
Kansas

Comm: 11/25/55 Comp: 12/6/55

Contractor: Peel Brothers, Inc.

Elevation:

Casing:

8 5/8" @ 193' Cem.

Production:

Figures below indicate bottom of formation

Sand	0'	90'
Shale		193
Shale and shells		800
Shale and sand		940
Shale, sand and red bed		1500
Red bed		1965
Anhydrite		2005
Red bed		2145
Shale, shells and Pyrite		2100
Shale and lime		3145
Shale		3323
Shale and lime		3625
Lime		3860
Shale and lime		4093
Shale, lime and chert		4148
Cherty lime		4305
Lime		4345
Cherty lime		4365
Total Depth		4365

This is to certify that the above information is to the best of my knowledge true and correct.

PEEL BROTHERS, INC.

BY

*[Signature]*

SUBSCRIBED AND SWORN TO before me this 20 day of December 1955

My commission expires September 28, 1957

*Norma L. Reese*  
Notary Public



NOTARY PUBLIC  
Wichita, Kansas

12-27-55

**PLUGGING**  
FILE SEC 17-T-8 R 24W  
BOOK PAGE 22 LINE 31