


15-065-20382-00-00

WELL PLUGGING RECORD

Give All Information Completely
Make Required Affidavit
Mail or Deliver Report to:
Conservation Division
State Corporation Commission
212 North Market, Insurance Bldg.
Wichita, Kansas

Graham County, Sec. 20 Twp. 8 Rge. 24 (E) (W)

Location as "NE/CNW/SW" or footage from lines NE SW SE
Lease Owner John O. Farmer, Inc.
Lease Name Law Well No. 1
Office Address Box 352, Russell, Kansas
Character of Well (completed as Oil, Gas or Dry Hole) Dryhole
Date well completed 10/13 1970
Application for plugging filed 10/15 1970
Application for plugging approved 10/13 1970
Plugging commenced 10/13 1970
Plugging completed 5:30 p.m. 10/13 1970
Reason for abandonment of well or producing formation _____

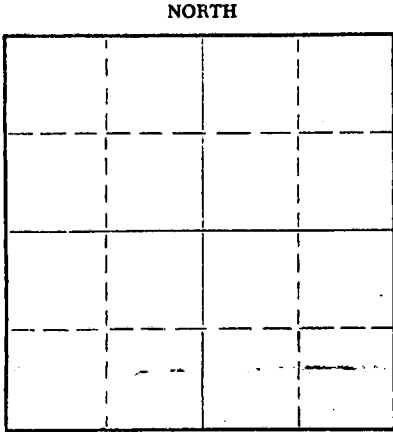

Locate well correctly on above Section Plat

If a producing well is abandoned, date of last production _____ 19____
Was permission obtained from the Conservation Division or its agents before plugging was commenced? yes

Name of Conservation Agent who supervised plugging of this well W. L. Nichols, Morland, Kansas
Producing formation _____ Depth to top _____ Bottom _____ Total Depth of Well 3845' Feet
Show depth and thickness of all water, oil and gas formations.

OIL, GAS OR WATER RECORDS

10-19-70

CASING RECORD

FORMATION	CONTENT	FROM	TO	SIZE	PUT IN	PULLED OUT

RECEIVED
STATE CORPORATION COMMISSION
OCT 19 1970
CONSERVATION DIVISION
Wichita, Kansas

Describe in detail the manner in which the well was plugged, indicating where the mud fluid was placed and the method or methods used in introducing it into the hole. If cement or other plugs were used, state the character of same and depth placed, from _____ feet to _____ feet for each plug set.

Plug # 1 1175' 70 Sx Cement
Plug #2 215' 20 sx Cement
Plug # 3 40' 10 sx Cement
Completed 5:30 p.m. 10/13/70
W. L. Nichols, State Plugger

(If additional description is necessary, use BACK of this sheet)

Name of Plugging Contractor John O. Farmer, Inc.
Address P. O. Box 352, Russell, Kansas 67665

STATE OF Kansas, COUNTY OF Russell, ss.
John O. Farmer, President (employee of owner) or (owner or operator) of the above-described well, being first duly sworn on oath, says: That I have knowledge of the facts, statements, and matters herein contained and the log of the above-described well as filed and that the same are true and correct. So help me God.

(Signature) John O. Farmer
P. O. Box 352, Russell, Kansas
(Address)

Subscribed and sworn to before me this 16th day of October, 1970
January 22, 1973

Virginia L. Harbaugh
Virginia L. Harbaugh Notary Public.

