

15-065-21092-00-00

STATE OF KANSAS  
STATE CORPORATION COMMISSION

WELL PLUGGING RECORD

Give All Information Completely  
Make Required Affidavit  
Mail or Deliver Report to  
Conservation Division  
State Corporation Comm.  
245 North Water  
Wichita, KS 67202

Graham County, Sec. 22 Twp. 8S Rge. 24W E/W  
Location as "NE/CNW $\frac{1}{4}$ /SW $\frac{1}{4}$ " or footage from lines  
SE NE SE

Lease Owner J. A. Allison  
Lease Name Getty Well No. 1


Office Address 300 W. Douglas, Ste. 305, Wichita, Kansas  
Character of Well (Completed as Oil, Gas or Dry Hole)  
Dry Hole

Date Well completed Dec. 20 19 78  
Application for plugging filed(verbally) Dec. 20 19 78  
Application for plugging approved(verbally) Dec. 20 19 78  
Plugging commenced Dec. 20 19 78  
Plugging completed Dec. 20 19 78

Reason for abandonment of well or producing formation  
No commercial quantity of oil or gas encountered  
If a producing well is abandoned, date of last production  
19

Was permission obtained from the Conservation Division or  
its agents before plugging was commenced? Yes

Name of Conservation Agent who supervised plugging of this well Leo Massey  
Producing formation Depth to top Bottom Total Depth of Well 3762'  
Show depth and thickness of all water, oil and gas formations.

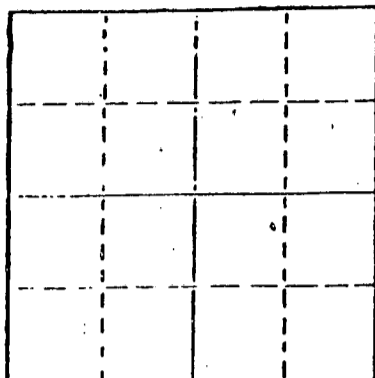

Locate well correctly on above  
Section Plat

OIL, GAS OR WATER RECORDS

CASING RECORD

FORMATION	CONTENT	FROM	TO	SIZE	PUT IN	PULLED OUT

Describe in detail the manner in which the well was plugged, indicating where the mud fluid  
was placed and the method or methods used in introducing it into the hold. If cement or other  
plugs were used, state the character of same and depth placed, from feet to  
feet for each plug set.

T.D. 3762'  
Set 1st plug at 900' with 70 sacks  
2nd plug at 240' with 20 sacks  
3rd plug at 40' solid bridge with 10 sacks  
Cemented with 50/50 posmix, 6% gel.  
Plug was down at 9:30 p.m., 12-20-78.

RECEIVED  
STATE CORPORATION COMMISSION  
JAN - 5 1979

CONSERVATION DIVISION  
Wichita, Kansas

(If additional description is necessary, use BACK of this sheet)

Name of Plugging Contractor Abercrombie Drilling, Inc.

1-579

STATE OF Kansas COUNTY OF Sedgwick, ss.  
Jack L. Partridge, Asst. Sec.-Treas. (employee of owner) or (owner or operator)  
of the above-described well, being first duly sworn on oath, says: That I have knowledge of  
the facts, statements, and matters herein contained and the log of the above-described well  
as filed and that the same are true and correct. So help me God.



(Signature) Jack L. Partridge  
801 Union Center, Wichita, Kansas  
(Address)

SUBSCRIBED AND SWORN TO before me this 3rd day of January, 19 79

Sherrie L. Brooks  
Notary Public.

My commission expires 8-21-82

CONTRACTOR'S WELL LOG

OPERATOR: J. A. Allison  
 CONTRACTOR: Abercrombie Drilling, Inc.  
 WELL NAME: Getty #1  
 LOCATION: SE NE SE, Section 22-8S-24W  
 Graham County, Kansas  
 SPUD DATE: December 14, 1978  
 COMPLETION DATE: December 20, 1978

0	248	Surface sand and shale
248	841	Sand and shale
841	2081	Shale and sand
2081	2114	Anhydrite
2114	2540	Shale
2540	2688	Shale and lime
2688	3760	Lime and shale
3760	3762	Lime
	3762	Rotary Total Depth

Spud hole at 6:00 p.m., December 14, 1978. Drilled 248' of 12 1/4" hole. Ran 6 joints of 8-5/8" casing. Set at 247' K.B. with 190 sacks of common cement, 3% Ca.Cl., 2% gel. Plug was down at 10:45 p.m., 12-14-78. Cement did circulate.

T.D. 3762'. Set 1st plug at 900' with 70 sacks, 2nd plug at 240' with 20 sacks, 3rd plug at 40' solid bridge with 10 sacks. Cemented with 50/50 posmix, 6% gel. Plug was down at 9:30 p.m., December 20, 1978.

SAMPLE TOPS:

Anhydrite 2081'  
 B/Anhydrite 2114'

RECEIVED  
 STATE CORPORATION COMMISSION

JAN - 5 1979  
 1-5-79  
 CONSERVATION DIVISION  
 Wichita, Kansas


STATE OF KANSAS )  
 ) ss  
 COUNTY OF SEDGWICK )

Jack L. Partridge, Assistant Secretary-Treasurer of Abercrombie Drilling, Inc., does hereby state that the above and foregoing is a true and correct copy of the log of the Getty #1, SE NE SE, Section 22-8S-24W, Graham County, Kansas.

ABERCROMBIE DRILLING, INC.

BY Jack L. Partridge  
 Jack L. Partridge, Asst. Sec.-Treas.

Subscribed and sworn to before me, a Notary Public, in and for the county and state aforesaid, as of this 3rd day of January, 1979.

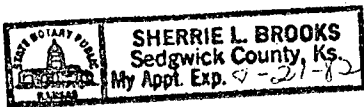

Sherrie Brooks  
 Sherrie Brooks, Notary Public

My commission expires 8-21-82.