


15-065-00362-00-00

STATE OF KANSAS
STATE CORPORATION COMMISSION

Give All Information Completely
Make Required Affidavit
Mail or Deliver Report to:
Conservation Division
State Corporation Commission
800 Bitting Building
Wichita, Kansas

WELL PLUGGING RECORD

NORTH

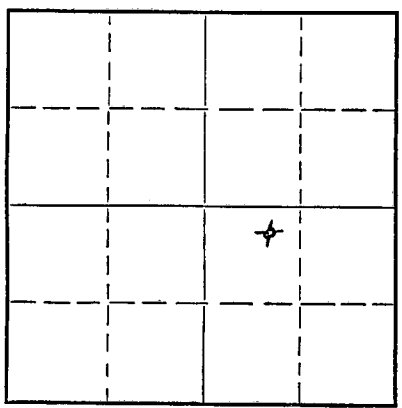

Locate well correctly on above
Section Plat

Graham County. Sec. 23 Twp. 8S Rge. 24 (E) W. (W)
Location as "NE/CNW 1/4 SW 1/4" or footage from lines NE NW SE
Lease Owner Peel-Hardman
Lease Name Gates Well No. 1
Office Address P. O. Box 359, Hoisington, Kansas
Character of Well (completed as Oil, Gas or Dry Hole) Dry Hole
Date well completed Oct. 2 1952
Application for plugging filed Oct. 2 1952
Application for plugging approved Oct. 2 1952
Plugging commenced Oct. 2 1952
Plugging completed Oct. 2 1952
Reason for abandonment of well or producing formation Dry Hole

If a producing well is abandoned, date of last production 19
Was permission obtained from the Conservation Division or its agents before plugging was commenced? Yes

Name of Conservation Agent who supervised plugging of this well E. R. Petty
Producing formation Depth to top Bottom Total Depth of Well 4180 Feet
Show depth and thickness of all water, oil and gas formations.

OIL, GAS OR WATER RECORDS

CASING RECORD

Formation	Content	From	To	Size	Put In	Pulled Out
		0	160'	8 5/8"	160'	None

Describe in detail the manner in which the well was plugged, indicating where the mud fluid was placed and the method or methods used in introducing it into the hole. If cement or other plugs were used, state the character of same and depth placed, from feet to feet for each plug set.

4180' - 156 1/2' - Heavy Rotary Mud
156 1/2' - 155' - Wooden Plug
155' - 109' - 15 sacks cement
109' - 47 1/2' - Heavy Rotary Mud
47 1/2' - 40' - Wooden Plug
40' - 6' - 10 sacks cement
6' - Surface - Cellar

RECEIVED
STATE CORPORATION COMMISSION
OCT - 9 1952
CONSERVATION DIVISION
Wichita, Kansas

Name of Plugging Contractor Glenn W. Peel
Address P. O. Box 359, Hoisington, Kansas

STATE OF Kansas, COUNTY OF Barton, ss.

Glenn W. Peel (employee of owner) or (owner/operator) of the above-described well, being first duly sworn on oath, says: That I have knowledge of the facts, statements, and matters herein contained and the log of the above-described well as filed and that the same are true and correct. So help me God. GLENN W. PEEL

(Signature) BY: [Signature]
P. O. Box 359
HOISINGTON, KANSAS (Address)

SUBSCRIBED AND SWORN to before me this 8th day of October, 1952

Manian M. Herbert Notary Public.

My commission expires June 4, 1955 23-8390-s 6-51-20M

PLUGGING
FILE SEC 22 T 8 R 262
BOOK PAGE 49 LINE 40

DRILLER'S LOG

Company: Peel-Hardman

NE NW Se

Farm: Gates Well No. 1

Sec. 23, Twp. 8S, Rge. 24W

Total Depth: 4180'

County: Graham, Kansas

Comm: 9-21-52 Comp: 10-2-52

Contractor: Glenn W. Peel

Elevation:

Casing:

8 5/8" 160' cem.

Production: Dry

Figures below indicate bottom of formations

Surface Clay	0 -	260
Shale & Sand		1450
Shale & Shells		1950
Red Bed		1960
Anhydrite		1990
Shale		2565
Shale & Lime		2910
Shale		3010
Lime & Shale		3185
Lime		3636
Lime & Shale		3725
Lime		3840
Lime & Shale		3930
Lime		3975
Lime & Shale		4025
Shale		4060
Lime		4180
Total Depth		4180

This is to certify that the above information is, to the best of our knowledge true and correct.

GLENN W. PEEL

BY: Wm Herbert

SUBSCRIBED AND SWORN to before me this 8th day of October, 1952.

My commission expires June 4, 1955

Marion M. Herbst
Notary Public



PLUGGING
FILE SEC 23 T 8 R 24
BOOK PAGE 19 LINE 40

10-9-52
RECEIVED
CORPORATION COMMISSION
OCT - 9 1952
CONSERVATION DIVISION
Wichita, Kansas